

15.159.03720.0000

WELL PLUGGING RECORD

STATE OF KANSAS
STATE CORPORATION COMMISSION


Give All Information Completely
Make Required Affidavit
Mail or Deliver Report to:
Conservation Division
State Corporation Commission
800 Bittling Building
Wichita, Kansas

FORMATION PLUGGING RECORD

Strike out upper line
when reporting plug-
ging off formations.

Rice County. Sec. 14 Twp. 20 Rge. (E) 8 (W)

Location as "NE $\frac{1}{4}$ NW $\frac{1}{4}$ SW $\frac{1}{4}$ " or footage from lines NE SW NE
Lease Owner Thos. H. Allan & Benton S. Brooks
Lease Name Williams Well No. 1
Office Address 921 Union National Bank Bldg., Wichita 2, Kansas
Character of Well (completed as Oil, Gas or Dry Hole) Dry Hole
Date well completed September 23 1949
Application for plugging filed September 23 1949
Application for plugging approved September 23 1949
Plugging commenced September 24 1949
Plugging completed September 27 1949
Reason for abandonment of well or producing formation Dry & Abandoned

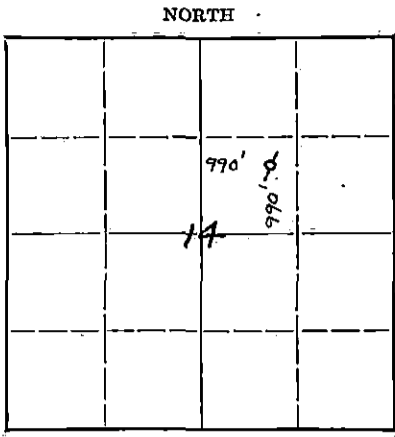

Locate well correctly on above Section Plat

If a producing well is abandoned, date of last production -- 19
Was permission obtained from the Conservation Division or its agents before plugging was commenced? Yes

Name of Conservation Agent who supervised plugging of this well Ruel Durkee
Producing formation Misener Sand Depth to top 3302' Bottom 3307' Total Depth of Well 3316' Feet
Show depth and thickness of all water, oil and gas formations.

OIL, GAS OR WATER RECORDS CASING RECORD

Formation	Content	From	To	Size	Put In	Pulled Out
				8 5/8"	149'	None
				5 1/2"	3304'	2616'

Describe in detail the manner in which the well was plugged, indicating where the mud fluid was placed and the method or methods used in introducing it into the hold. If cement or other plugs were used, state the character of same and depth placed, from feet to feet for each plug set.

- 3316 - 3285 6 sacks cement
- 3285 - 145 Heavy Rotary Mud
- 145 - 115 Bridge & 15 sacks cement
- 115 - 20 Heavy Mud
- 20 - Surface Bridge & 5 sacks cement

RECEIVED
Conservation Div.
OCT 10 1949
STATE CORPORATION COMMISSION
KANSAS

(If additional description is necessary, use BACK of this report)
Correspondence regarding this well should be addressed to Thos. H. Allan
Address 921 Union National Bank Bldg., Wichita 2, Kansas

STATE OF KANSAS, COUNTY OF SEDGWICK, SS.
Thos. H. Allan (owner or operator) of the above-described well,

being first duly sworn on oath, says: That I have knowledge of the facts, statements, and matters herein contained and the log of the above-described well as filed and that the same are true and correct. So help me God.

(Signature) Thos. H. Allan

921 Union National Bank Bldg., Wichita 2, Kansas (Address)

SUBSCRIBED AND SWORN to before me this 8th day of October, 1949

Ocie M. Stewart
Notary Public.

My commission expires June 14, 1950

WELL PLUGGING
FILE SEC 14 T 20 R 8 C
- 117

149' of 8 5/8" - 100 sx
3304' of 5 1/2" - 100 sx Pulled 2616

Allan & Brooks #1 WILLIAMS
NE SW NE 14-20-8W
Rice County, Kansas
Comm: 9/5/49 Compl: 9/27/49
Contractor: Tom Allan
Elevation 1648
I.P. Dry & Abandoned

0 - 65 surface soil & sand
168 red beds
180 gypsum & anhydrite
500 red beds
750 shale
1000 salt & shale
1100 anhydrite
1200 shale
1230 dolomite
1265 shale
1360 lime
1380 cherty lime
1585 shale & shells
1605 cherty lime
1800 lime & shale
2030 shale
2050 lime
2330 shale & shells
2360 sand & shale
2430 lime
2500 shale & shells
2670 lime
2680 black shale
2710 lime
2770 sand & shale
2810 shale
2815 brown lime
2840 shale
2870 lime
2875 oolitic lime
2895 lime
2905 shale
2930 lime
2940 shale
2985 lime
3015 shale
3022 lime
3030 shale
3050 lime
3065 shale
3075 lime
3105 shale
3110 cherty lime
3170 lime & shale
3200 shale

3230 cherty red mud
3302 red & green shale
3306 sand
Changed to Cable Tools 5 1/2" @ 3305
3307 sand
3310 shale
3316 dolomite
Perforated 3301 - 3307
Treated 100 gal. acid
Swab 2 gal. Acid/hr

FORMATIONS
2370 Top Topeka
2670 Top Heebner
2840 Top Lansing
3200 Top Conglomerate
3230 Possible Top Kinderhook
3302 Top Misener
3310 Top Maquoketa

I certify that the above is a true and correct copy of the well log on the above test.

Tom H. Allan

Subscribed and sworn to before me this 8th day of October, 1949.

Oris M. Stewart
Notary Public

My Commission expires June 14, 1950.

RECEIVED

PLUGGING
FILE SEC. 14 T. 20 R. 8 W
BOOK PAGE 167 LINE 22

