


WELL PLUGGING RECORD

Give All Information Completely  
Make Required Affidavit  
Mail or Deliver Report to:  
Conservation Division  
State Corporation Commission  
800 Bitting Building  
Wichita, Kansas

NORTH

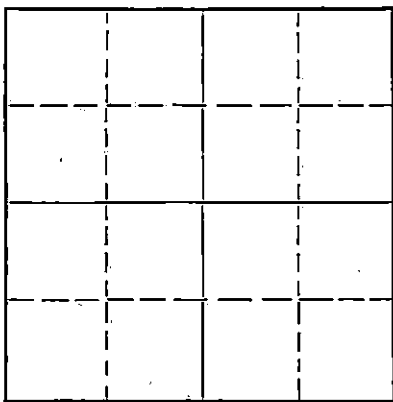

Locate well correctly on above  
Section Plat

Rice County, Sec. 14 Twp. 20S Rge. XXX(B) 8 (W)

Location as "NE/CNW $\frac{1}{4}$ /SW $\frac{1}{4}$ " or footage from lines SE SE NW  
Lease Owner Smitherman & Cohen Drilling Company  
Lease Name Stahl Well No. 3  
Office Address P. O. Box 692 El Dorado, Kansas  
Character of Well (completed as Oil, Gas or Dry Hole) Oil  
Date well completed 11 - 18 19 49  
Application for plugging filed 4 - 10 19 52  
Application for plugging approved 4 - 17 19 52  
Plugging commenced 4 - 19 19 52  
Plugging completed 5 - 1 19 52  
Reason for abandonment of well or producing formation Oil Depleted

If a producing well is abandoned, date of last production 19  
Was permission obtained from the Conservation Division or its agents before plugging was commenced? Yes

Name of Conservation Agent who supervised plugging of this well Ruell Durkee  
Producing formation Sand Depth to top 3299 Bottom 3304 Total Depth of Well 3304 Feet  
Show depth and thickness of all water, oil and gas formations.

OIL, GAS OR WATER RECORDS

CASING RECORD

Formation	Content	From	To	Size	Put In	Pulled Out
				5 1/2"		2787'

Describe in detail the manner in which the well was plugged, indicating where the mud fluid was placed and the method or methods used in introducing it into the hole. If cement or other plugs were used, state the character of same and depth placed, from \_\_\_\_\_ feet to \_\_\_\_\_ feet for each plug set.

Rocked hole from 3304' to 3290' and ran 6 sacks of cement. Bailed off fluid and mudded hole to 150'. Set 15' rock bridge and ran 25 sacks of cement. Plugging job did not hold. Drilled out plug and pumped in 25 sacks of cement. Mudded hole to 40' and ran 10 sacks of cement. Plugging completed.

(If additional description is necessary, use BACK of this sheet)

Name of Plugging Contractor West Supply Company  
Address Chase, Kansas

STATE OF Kansas, COUNTY OF Butler, SS.  
L. C. Smitherman (employee of owner) or (owner or operator) of the above-described well, being first duly sworn on oath, says: That I have knowledge of the facts, statements, and matters herein contained and the log of the above-described well as filed and that the same are true and correct. So help me God. SMITHERMAN & COHEN DRILLING COMPANY

(Signature) L. C. Smitherman

P. O. Box 692 El Dorado, Kansas  
(Address)

SUBSCRIBED AND SWORN to before me this 15th day of May, 1952

My commission expires March 3, 1955

Edith A. Higgett  
Notary Public.

23-8390-s 6-51-20M

**PLUGGING**  
FILE SOC 14 T 20 R 80  
BOOK 7 PAGE 10

RECEIVED  
STATE CORPORATION COMMISSION  
MAY 16 1952 5-16-52  
CONSERVATION DIVISION  
Wichita, Kansas

## STAHL WELL # 3

8 5/8" @ 170' 125' sx  
5 1/2" @ 3298' 75' sx

Allan & Brooks  
SE SE NW 14-20-8W  
Lyons Pool, Rice County, Kansas

Comm: 10/27/49 Compl: 11/18/49  
Contractor: Tom Allan  
Elevation: 1644  
I. P. Potential Flow 109 bbl./day  
1/2" Choke

0 -	65	Soil & Sand
	170	Red Beds
	180	Anhydrite
	500	Red Beds
	750	Shale
	900	Salt & Shale
	1000	Shale
	1150	Anhydrite & Shale
	1400	Lime & Shale
	2350	Shale & Lime Shells
	2700	Lime & Shale Breaks
	2803	Shale
	2810	Brown Lime
	2834	Shale & Sandstone
	2861	Lime & Shale Breaks
	2872	Soft Porous Oolitic Lime
	2890	Lime & Shale Breaks
	2895	Oolitic Lime
	2908	Shale
	2945	Lime & Shale Breaks
	2950	Oolitic Lime
	2966	Lime
	3000	Shale & Shells
	3020	Lime
	3032	Shale
	3052	Soft Lime Partly Oolitic
	3160	Lime & Shale
	3200	Shale
	3218	Red Shale Conglomerate
	3228	Cherty Conglomerate
	3296	Red & Gray Shale
	3299	Sandstone
	Cemented 5 1/2" Casing	
	3303	Sandstone Partly Saturated
	3304	T. D. Shale & Dolomite
	Flowed 3 1/2 bbl/hr 3/8 Choke	

FORMATIONS

2803	Top Iatan
2834	Top Lansing
3200	Top Conglomerate
3296	Top Misener
3303	Top Maquoketa

LOGGING	
FILE	SEC 14 T 20 R 8W
BOOK	PAGE 9 LINE 10

RECEIVED  
STATE CORPORATION COMMISSION  
MAY 1 1950  
DORIS L. MOORE, CLERK  
Lynch, Kansas