


STATE OF KANSAS
STATE CORPORATION COMMISSION

Give All Information Completely
Make Required Affidavit
Mail or Deliver Report to:
Conservation Division
State Corporation Commission
211 No. Broadway
Wichita, Kansas

WELL PLUGGING RECORD

NORTH

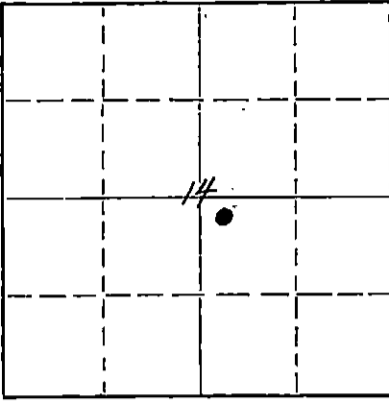

Locate well correctly on above
Section Plat

Rice County, Sec. 14 Twp. 20 Rge. (E) 8 (W)
Location as "NE/CNW/SW" or footage from lines NW NW SE
Lease Owner Thos. H. Allan, et al
Lease Name Blevins Well No. 1
Office Address 925 Union Center, Wichita 2, Kansas
Character of Well (completed as Oil, Gas or Dry Hole) Oil
Date well completed February 5 1950
Application for plugging filed January 8 1959
Application for plugging approved January 9 1959
Plugging commenced January 13 1959
Plugging completed January 16 1959
Reason for abandonment of well or producing formation Exhausted

If a producing well is abandoned, date of last production January 9 19 59
Was permission obtained from the Conservation Division or its agents before plugging was commenced? Yes

Name of Conservation Agent who supervised plugging of this well Gilbert Toman
Producing formation Conglomerate Depth to top 3207 Bottom 3237 Total Depth of Well 3316 Feet
Show depth and thickness of all water, oil and gas formations.

OIL, GAS OR WATER RECORDS

CASING RECORD

FORMATION	CONTENT	FROM	TO	SIZE	PUT IN	PULLED OUT
				8 5/8"	157'	None
				5 1/2"	3337'	2710'

Describe in detail the manner in which the well was plugged, indicating where the mud fluid was placed and the method or methods used in introducing it into the hole. If cement or other plugs were used, state the character of same and depth placed, from _____ feet to _____ feet for each plug set.

3316 - 3220	Sand
3220 - 3210	5 sacks of cement
3210 - 200	Mud
200 - 140	Rock Bridge and 25 sacks of cement
140 - 40	Mud
40 - Base of Cellar	Rock Bridge and 10 sacks of cement

RECEIVED
STATE CORPORATION COMMISSION

JAN 23 1959

CONSERVATION DIVISION
Wichita, Kansas

RECEIVED
STATE CORP.

JAN 21 1959

CONSERVATION DIVISIC
Wichita, Kansas

(If additional description is necessary, use BACK of this sheet)

Name of Plugging Contractor Southwest Casing Pulling Co., Inc.
Address Great Bend, Kansas

STATE OF KANSAS, COUNTY OF SEDGWICK, ss.
Thos. H. Allan (employee of owner) or (owner or operator) of the above-described well, being first duly sworn on oath, says: That I have knowledge of the facts, statements, and matters herein contained and the log of the above-described well as filed and that the same are true and correct. So help me God.

(Signature) Thos H, Allan
925 Union Center, Wichita 2, Kansas
(Address)

SUBSCRIBED AND SWORN TO before me this 20th day of January, 19 59

Ocie M. Stewart
Notary Public.

My commission expires June 14, 1962

PLUGGING
FILE SEC. 14 T. 20 R. 8W
BOOK PAGE 9 LINE 33


Company - ALLAN & BROOKS
Farm - Blevins No. 1

SEC. 14-- 7. 20 R. 8W
NW NW SE

Total Depth. 3363 PB 3316
Comm. 1-14-50 Comp. 2-5-50
Shot or Treated.
Contractor. Tom Allan
Issued. 8-25-51

County. Rice

KANSAS

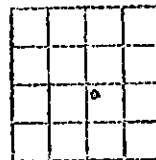

Elevation. 1644 Floor

Production. Potential 49 bbls

CASING:

8 5/8" 157' cem w/135 sx
5 1/2" 3337' cem w/100 sx

Figures Indicate Bottom of Formations.

soil, sand, gravel 65
red beds 166
anhydrite 178
red beds 500
shale 750
salt, shale 1000
anhydrite 1100
shale, shells 2350
lime, shale partings 2700
shale 2809
lime brown 2813
shale 2824
sand 2829
shale 2839
lime 2852
shale 2860
lime 2866
shale 2870
lime soft oolitic 2874
lime 2887
shale 2895
lime 2901
shale 2911
lime 2924
shale 2928
lime 2941
shale 2946
lime soft oolitic 2958
shale 2968
lime 2988
shale 2993
lime 3010
lime soft oolitic 3015
lime 3033
shale 3040
lime oolitic soft 3055
shale, lime 3080
lime soft oolitic 3083
lime 3105
shale 3120
lime cherty 3140
shale 3155
lime 3160
shale, lime 3207
shale red congl. 3228
chert varicolor (Pay) 3237
shale red 3265
lime, shale 3280
shale red & gray 3335
set 5 1/2" casing &
continued with 4 3/4"
rock bit.
sandstone - water 3346
dolomite 3361
lime white xyl. 3363
Total Depth
Plugged back to 3316

Tops:
Anhydrite 166
Casing 2839

conglomerate 3207
Misener 3335
Maquoketa 3346
Viola 3361

Swabbed salt water from
Misener Sand
Lane-Wells plug: Top 3316
1 sack cement to top of plug
Perforated 3223-3240 - 48 holes
1000' oil in 4 hours.

RECEIVED
STATE CORPORATION COMMISSION
JAN 9 1959
CONSERVATION DIVISION
Wichita, Kansas

PLUGGING
FILE SEC 14 T 20 R 8W
BOOK PAGE 9 LINE 33