


STATE OF KANSAS  
STATE CORPORATION COMMISSION

WELL PLUGGING RECORD

Give All Information Completely  
Make Required Affidavit  
Mail or Deliver Report to:  
Conservation Division  
State Corporation Commission  
800 Biting Building  
Wichita, Kansas

RICE County, Sec. 33 Twp 20 Rge. 8 (E) 8 (W)  
Location as "NE/CNW 1/4 SW 1/4" or footage from lines: CE/2 NE/4 SE/4  
Lease Owner: Thos. H. Allan  
Lease Name: Henry Fayne Evans Well No. 1  
Office Address: 1221 Union National Bank Building, Wichita 2, Kansas  
Character of Well (completed as Oil, Gas or Dry Hole): Dry Hole  
Date well completed: August 29 19 51  
Application for plugging filed: August 29 19 51  
Application for plugging approved: August 29 19 51  
Plugging commenced: August 29 19 51  
Plugging completed: August 30 19 51  
Reason for abandonment of well or producing formation: Dry

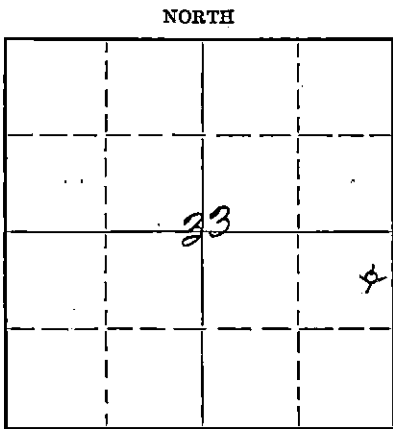

Locate well correctly on above  
Section Plat

Name of Conservation Agent who supervised plugging of this well: Ruel Durkee  
Producing formation: Misener Sand Depth to top: 3354 Bottom: ----- Total Depth of Well: 3361 1/2 Feet  
Show depth and thickness of all water, oil and gas formations.

OIL, GAS OR WATER RECORDS

CASING RECORD

Formation	Content	From	To	Size	Put In	Pulled Out
				8 5/8"	212'	None
				5 1/2"	3358'	2782'

Describe in detail the manner in which the well was plugged, indicating where the mud fluid was placed and the method or methods used in introducing it into the hole. If cement or other plugs were used, state the character of same and depth placed, from \_\_\_\_\_ feet to \_\_\_\_\_ feet for each plug set.

3361 1/2'	-	3290'	Filled with Gravel
3290	-	3210	6 sacks cement
3210	-	200	Heavy Mud
200	-	150	Bridge and 15 sacks Cement
150	-	30	Mud
30	-	Surface	5 sacks Cement

(If additional description is necessary, use BACK of this sheet)

Correspondence regarding this well should be addressed to: Thos. H. Allan  
Address: 1221 Union National Bank Building, Wichita 2, Kansas

STATE OF KANSAS, COUNTY OF SEDGWICK, ss.  
Thos. H. Allan (employee of owner) or (owner or operator) of the above-described well,  
being first duly sworn on oath, says: That I have knowledge of the facts, statements, and matters herein contained and the log of the above-described well as filed and that the same are true and correct. So help me God.

(Signature) Thos. H. Allan  
1221 Union National Bank Bldg., Wichita 2, Kansas  
(Address)

SUBSCRIBED AND SWORN to before me this 5th day of September 19 51

My commission expires June 1/31 1951  
FILE SEC 33 T 20 R 2  
BOOK PAGE 107 LINE 6

RECEIVED  
Pie M. Stewart  
Notary Public.  
SEP 6 X 1951 9-6-51  
CONSERVATION DIVISION  
Wichita, Kansas

15159.002.00.0000

212' of 8 5/8" - 108 sx  
3358' of 5 1/2" - 75 sx  
2782' of 5 1/2" - Pulled

ALLAN et al #1 HENRY EVANS  
CE/2 NE SE 33-20-8W  
Rice County, Kansas  
Comm: 7/31/51 Compl: 8/29/51  
Contractor: Tom Allan  
Elevation: 1662 RB  
I.P.: D&A

Depth from Rotary Bushings

0 - 90	Surface Soil and Sand
206	Red Beds
212	Anhydrite
290	Red Beds
345	Red & Green Shale
600	Red & Gray shale with streaks of Gypsum
790	Red & Gray Shale
1005	Gray Shale & Salt
1200	Anhydrite
1290	Shale & Anhydrite
1385	Lime & Shale
1420	Lime
1450	Lime & Shale
1480	Lime & Chert
1575	Shale & Shells
1730	Lime & Shale
1800	Lime
1860	Shale
1945	Lime
1985	Shale & Shells
2050	Lime & Shale
2125	Shale
2415	Lime & Shale
2450	Sand
2555	Lime
2590	Shale
2745	Lime
2820	Shale
2885	Lime
2905	Sand & Shale
3055	Lime with Shale breaks
3105	Lime & Shale
3160	Lime with Shale breaks
3185	Red & Gray Shale
3270	Lime & Shale
3302	Red & Gray shale with Orange & Buff Chert
3311	Red Shale & Varicolored Chert
3321	Red & Green Shale
3354	Lime
3361 1/2	(TD) Sand, slightly oil stained

Drilled Plug & Clean out to Bottom (3361 1/2).  
Swabbed 3 bbl. Water per hour.  
Plug back to 3349 and Perforate 48 Shots from 3302-13. No Fluid.

FORMATIONS:

Anhydrite	206 RB
Brown Lime	2878 RB
Lansing	2905 RB
Cherty Conglomerate	3302 RB
Kinderhook Shale	3311 RB
Kinderhook Lime	3321 RB
Misener Sand	3354 RB

I certify that the above is a true and correct copy of the well log on the above test.

Thomas H. Allan

Subscribed and sworn to before me this 30th day of August, 1951.

Quinn M. Stewart  
Notary Public

My Commission expires June 14, 1954

RECEIVED  
KANSAS OIL AND GAS COMMISSION

SEP 6 X 1951

CONSERVATION DIVISION  
Wichita, Kansas

PLUGGING

FILE SEC 33-20-8W  
BOOK PAGE 67 LINE 6