


STATE OF KANSAS
STATE CORPORATION COMMISSION

Give All Information Completely
Make Required Affidavit
Mail or Deliver Report to:
Conservation Division
State Corporation Commission
211 No. Broadway
Wichita, Kansas

WELL PLUGGING RECORD

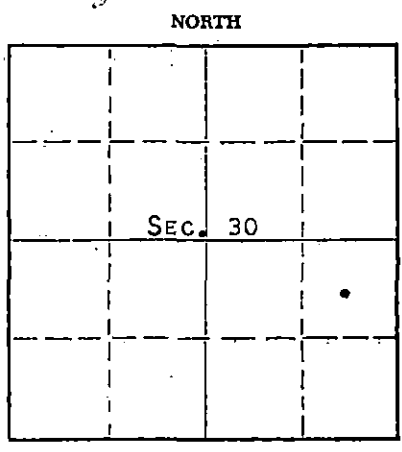

Locate well correctly on above Section Plat

RICE County. Sec. 30 Twp. 20S. Rge. 8W (X) (W)
Location as "NE/CNWSW¼" or footage from lines APPROX. C NE SE
Lease Owner PETROLEUM, INC.,
Lease Name PEARSON (TWIN) Well No. 1
Office Address R. R. #2, GREAT BEND, KANSAS
Character of Well (completed as Oil, Gas or Dry Hole) DRY HOLE
Date well completed 11-5 1963
Application for plugging filed 11-6 1963
Application for plugging approved 11-5 1963
Plugging commenced 11-5 1963
Plugging completed 11-5 1963
Reason for abandonment of well or producing formation NO PRODUCIBLE ZONES

If a producing well is abandoned, date of last production -- 19
Was permission obtained from the Conservation Division or its agents before plugging was commenced? YES

Name of Conservation Agent who supervised plugging of this well GILBERT TOMAN
Producing formation _____ Depth to top _____ Bottom _____ Total Depth of Well 3654 Feet
Show depth and thickness of all water, oil and gas formations.

OIL, GAS OR WATER RECORDS

CASING RECORD

FORMATION	CONTENT	FROM	TO	SIZE	PUT IN	PULLED OUT
				8-5/8	221	NONE

Describe in detail the manner in which the well was plugged, indicating where the mud fluid was placed and the method or methods used in introducing it into the hole. If cement or other plugs were used, state the character of same and depth placed, from _____ feet to _____ feet for each plug set.

MUDDED UP WITH HEAVY MUD TO 210', FOLLOWED BY WOODEN PLUG. PLACED 20 SACKS CEMENT THRU DRILL PIPE ON TOP OF PLUG. MUDDED UP WITH HEAVY MUD TO 40', FOLLOWED BY WOODEN PLUG & 10 SACKS CEMENT TO BASE OF WELL CELLAR.

RECEIVED
STATE CORPORATION COMMISSION

NOV 12 1963
11-12-63
CONSERVATION DIVISION
Wichita, Kansas

(If additional description is necessary, use BACK of this sheet)

Name of Plugging Contractor GARVEY DRUG CO.
Address R. R. #2, GREAT BEND, KANSAS

STATE OF KANSAS, COUNTY OF BARTON, ss.
MONTE CHADD (employee of owner) or (owner) of the above-described well, being first duly sworn on oath, says: That I have knowledge of the facts, statements, and matters herein contained and the log of the above-described well as filed and that the same are true and correct. So help me God. MONTE CHADD, DIST. PROD. SUPT.

(Signature) *Monte Chadd*
R. R. #2, GREAT BEND, KANSAS
(Address)

SUBSCRIBED AND SWORN TO before me this 11TH day of NOVEMBER, 19 63

My commission expires SEPTEMBER 23, 1967
Edward G. Gower Notary Public

WELL LOG

15.159.00664.0000

COMPANY Petroleum, Inc.

SEC. 30 T.20S R.8W

FARM Pearson Twin NO. 1

LOC. 12' East of NE - SE


TOTAL DEPTH 3654'

COUNTY Rice

COMM. 10-26-63

COMP. 11-5-63

CONTRACTOR Garvey Drilling Company

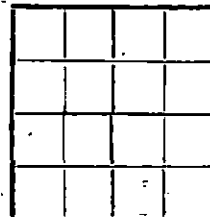

CASING 8 5/8" @ 221' w/225 sx

ELEVATION 1678' D.F.

PRODUCTION D & A

FIGURES INDICATE BOTTOM OF FORMATIONS

- 220' Sand
- 221' Red Bed and Shale
- 252' Shale and Red Bed
- 280' Anhydrite
- 940' Shale and Shells
- 1125' Red Bed and Shale
- 1500' Lime and Shale
- 1715' Shale and Lime
- 1950' Lime and Shale
- 2155' Shale
- 2375' Shale and Lime Streaks
- 2435' Lime and Shale
- 2745' Shale and Lime
- 2845' Lime
- 2983' Shale and Lime
- 3339' Lime
- 3380' Lime and Shale
- 3430' Lime
- 3435' Sand and Shale
- 3510' Lime & Shale
- 3550' Lime
- 3600' Lime and Shale
- 3654' Lime
- 3654' RTD

RECEIVED
STATE CORPORATION COMMISSION

RECEIVED
STATE CORPORATION COMMISSION

NOV 12 1963

CONSERVATION DIVISION
Wichita, Kansas

State of Kansas
County of Barton

I, Sam N. Stephens of Garvey Drilling Co.

upon oath state the above and foregoing is a true and correct copy of the log of the Pearson Twin #1 well.

Sam N. Stephens

Subscribed and sworn to before me this 8th day of November

1963

My Commission Expires: September 23rd, 1967

Richard D. Dyer
NOTARY PUBLIC