


Give All Information Completely  
Make Required, David  
Mail or Deliver part to:  
Conservation Division  
State Corpora in Commission  
211 No. Brea by  
Wichita, Kan.

WELL PLUGGING RECORD

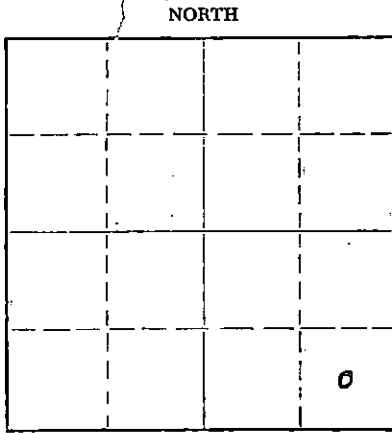

Locate well correctly on above  
Section Plat

Barton

County. Sec. 10 Twp. 20s Rge. 12 (X) W (W)

Location as "NE/CNW/SW" or footage from lines SE SE SE

Lease Owner N. H. Veail

Lease Name Hood Well No. 1

Office Address 1401 McKinley, Great Bend, Kansas

Character of Well (completed as Oil, Gas or Dry Hole) Dry Hole

Date well completed February 20 19 64

Application for plugging filed February 21 19 64

Application for plugging approved February 21 19 64

Plugging commenced February 21 19 64

Plugging completed February 21 19 64

Reason for abandonment of well or producing formation Dry Hole

If a producing well is abandoned, date of last production 19

Was permission obtained from the Conservation Division or its agents before plugging was commenced? Yes

Name of Conservation Agent who supervised plugging of this well Don Truan, Russell, Kansas

Producing formation \_\_\_\_\_ Depth to top \_\_\_\_\_ Bottom \_\_\_\_\_ Total Depth of Well 3408 Feet

Show depth and thickness of all water, oil and gas formations.

OIL, GAS OR WATER RECORDS

CASING RECORD

FORMATION	CONTENT	FROM	TO	SIZE	PUT IN	PULLED OUT
		0	210	8 5/8	210	NONE

Describe in detail the manner in which the well was plugged, indicating where the mud fluid was placed and the method or methods used in introducing it into the hole. If cement or other plugs were used, state the character of same and depth placed, from \_\_\_\_\_ feet to \_\_\_\_\_ feet for each plug set.

Hole filled with heavy mud to 200 feet

Placed 1/2 sack hulls and HOWCO plug @ 200 feet with 25 sacks cement on top plug through drill pipe

Hole filled with heavy mud to 10 feet

Placed 1/2 sack hulls and HOWCO plug @ 10 feet with 12 sacks cement on top plug

RECEIVED  
STATE CORPORATION COMMISSION

FEB 28 1964

2-28-64

CONSERVATION DIVISION  
Wichita, Kansas

(If additional description is necessary, use BACK of this sheet)

Name of Plugging Contractor Ja-Le Contracting, Inc. Lyons, Kansas

Address \_\_\_\_\_

STATE OF KANSAS, COUNTY OF BARTON SEDGWICK, ss.

N. H. Veail

(owner or operator) of the above-described well, being first duly sworn on oath, says: That I have knowledge of the facts, statements, and matters herein contained and the log of the above-described well as filed and that the same are true and correct. So help me God.

(Signature)

N. H. Veail

Great Bend, Kansas

(Address)

SUBSCRIBED AND SWORN TO before me this 26th day of February, 19 64

My commission expires

May 13, 1966

Notary Public.



DRILLERS' LOG

15.009.05237.0000

OPERATOR: N. H. Veail, Great Bend, Kansas  
 LOCATION: SE SE SE Section 10, T. 20 S., R. 12 W.  
 Barton County, Kansas  
 No. 1 Hood  
 CONTRACTOR: Ja-Le Contracting, Inc., Lyons, Kansas  
 CASING RECORD: 8 5/8" @ 210 feet  
 COMMENCED: 2-13-64 COMPLETED: 2-20-64  
 TOTAL DEPTH: 3408

RECEIVED  
STATE CORPORATION COMMISSION

FEB 28 1964

CONSERVATION DIVISION  
Wichita, Kansas

LOG

Shale	0-595
Anhydrite	610
Shale	1900
Lime & Shale	2700
Lime	2984
Shale	2987
Lime & Shale	3123
Lime	3360
Shale, Sand & Lime	3386
Dolomite	3408

The undersigned, N. H. Veail, hereby certifies that the above log is a true and correct log of the formations encountered during drilling the above well as reflected by the daily drilling reports.

*N. H. Veail*  
N. H. Veail

STATE OF KANSAS )  
COUNTY OF SEDGWICK ) SS

Before me, the undersigned, a Notary Public, within and for said County and State, on this 26th day of February, 1964, personally appeared N. H. Veail to me personally known to be the identical person who executed the within and foregoing instrument and acknowledged to me that he executed the same as his free and voluntary act and deed for the uses and purposes therein set forth.

IN WITNESS WHEREOF, I have hereto set my hand and official seal the day and year above last written.

*Dale Schib*  
Notary Public

My commission Expires: May 13, 1966