

STATE OF KANSAS
STATE CORPORATION COMMISSION

WELL PLUGGING RECORD

Give All Information Completely
Make Required Affidavit
Mail or Deliver Report to:
Conservation Division
State Corporation Commission
212 North Market, Insurance Bldg.
Wichita, Kansas

Barton

County. Sec. 10 Twp. 20 Rge. 12 (E) W (W)

Location as "NE/CNW%SW%" or footage from lines C/S2/S2/SW4

Lease Owner John A. Trimmell

Lease Name Hood Well No. 2

Office Address Box 322, Great Bend, Kansas

Character of Well (completed as Oil, Gas or Dry Hole) Dry Hole

Date well completed 10-24 19 63

Application for plugging filed 10-24 19 63

Application for plugging approved 10-24 19 63


Plugging commenced 10-24 19 63

Plugging completed 10-24 19 63

Reason for abandonment of well or producing formation Dry Hole

If a producing well is abandoned, date of last production 19

Was permission obtained from the Conservation Division or its agents before plugging was commenced? Yes

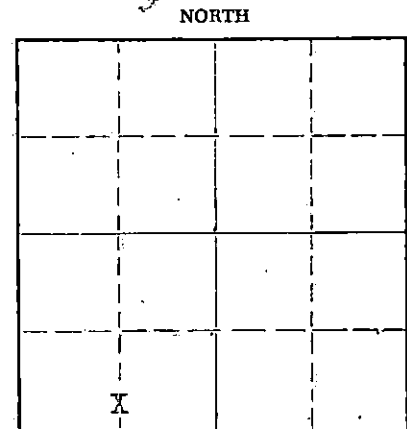

Locate well correctly on above Section Flat

Name of Conservation Agent who supervised plugging of this well Don Truan, Russell, Kansas

Producing formation Depth to top Bottom Total Depth of Well 3455 Feet

Show depth and thickness of all water, oil and gas formations.

OIL, GAS OR WATER RECORDS

CASING RECORD

FORMATION	CONTENT	FROM	TO	SIZE	PUT IN	PULLED OUT
Surface Pipe		0	201'	8 5/8	201'	None

Describe in detail the manner in which the well was plugged, indicating where the mud fluid was placed and the method or methods used in introducing it into the hole. If cement or other plugs were used, state the character of same and depth placed, from feet to feet for each plug set.

First plug set at 200' with 25 sacks cement on top of plug. Filled with mud to 40'. Second plug set at 40' with 12 sacks cement on top of plug.

RECEIVED
STATE CORPORATION COMMISSION

NOV 5 1963 11-5-63

CONSERVATION DIVISION
Wichita, Kansas

(If additional description is necessary, use BACK of this sheet)
Name of Plugging Contractor Chas. Hulme Drilling Contractor
Address Box 836, Great Bend, Kansas

STATE OF Kansas, COUNTY OF Barton, ss.
John A. Trimmell

(employee of owner) or (owner or operator) of the above-described well, being first duly sworn on oath, says: That I have knowledge of the facts, statements, and matters herein contained and the log of the above-described well as filed and that the same are true and correct. So help me God.

(Signature) John A. Trimmell
Box 322, Great Bend, Kansas
(Address)

SUBSCRIBED AND SWORN TO before me this 2nd day of November, 19 63

My commission expires April 24, 1967

Notary Public.

JOHN TRIMMELL
 Box 322
 Great Bend, Kansas

WELL LOG

Hood #2 c/S2/S2/SW4 10-20-12W Barton County, Kansas

0	201	Sand & Shale		
201	619	Red Bed and Shale	Elevation	1818' D.F.
619	634	Anhydrite		1820' R.B.
634	810	Shale		
810	1000	Shale and Shells		
1000	1285	Shale	Heebner	3012'
1285	1770	Shale and Lime	Kansas City	3146'
1770	1890	Lime	Conglormorate	3382'
1890	2140	Lime and Shale	Arbuckle	3400'
2140	2310	Shale		
2310	2500	Shale and Lime		
2500	2700	Lime and Shale		
2700	3038	Lime		
3038	3157	Lime and Shale Lime		
3157	3345	Lime and Shale		
3345	3415	Lime Shale		
3415	3455	Lime		
3455		T. D.		


RECEIVED
 STATE CORPORATION COMMISSION
 NOV 5 1963
 CONSERVATION DIVISION
 Wichita, Kansas

STATE OF KANSAS
 COUNTY OF BARTON ss

C. E. Byars, partner of Chas. Hulme Drilling Contractor, being first duly sworn on oath says: That I have knowledge of the facts, statements, and matters herein contained and the log of the above described well as filed and that the same are true and correct.

C. E. Byars
 C. E. Byars

Subscribed and sworn before me this 2nd day of November, 1963.

 

R. D. Plumbo
 Notary Public Barton County

My Commission Expires: 4-24-67