

WELL PLUGGING RECORD

Give All Information Completely
Make Required Affidavit
Mail or Deliver Report to:
Conservation Division
State Corporation Commission
800 Bitting Building
Wichita, Kansas

Barton County, Sec. 6 Twp. 20 Rge. 12 ~~13~~ (W)

Location as "NE/CNW/SW" or footage from lines NW NE/4 SE/4 NE/4

Lease Owner Hilton Drilling Company, Inc.

Lease Name Birzer Well No. 1

Office Address 2421 Tenth Street, Great Bend, Kansas

Character of Well (completed as Oil, Gas or Dry Hole) Dry Hole

Date well completed April 6 1952

Application for plugging filed April 5 1952

Application for plugging approved April 5 1952


Plugging commenced April 5 1952

Plugging completed April 5 1952

Reason for abandonment of well or producing formation dry hole

If a producing well is abandoned, date of last production 19

Was permission obtained from the Conservation Division or its agents before plugging was commenced? yes

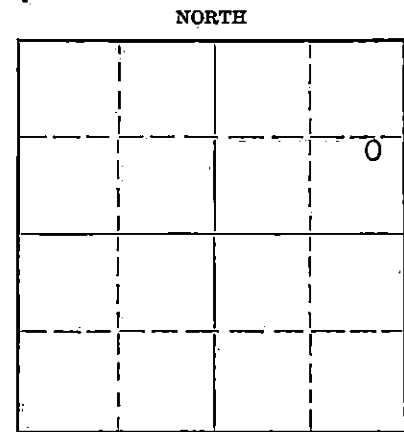

Locate well correctly on above Section Plat

Name of Conservation Agent who supervised plugging of this well C. D. Stough

Producing formation Depth to top Bottom Total Depth of Well 3432 Feet

Show depth and thickness of all water, oil and gas formations.

OIL, GAS OR WATER RECORDS

CASING RECORD

Formation	Content	From	To	Size	Put In	Pulled Out
				8 5/8"	157'	none

Describe in detail the manner in which the well was plugged, indicating where the mud fluid was placed and the method or methods used in introducing it into the hole. If cement or other plugs were used, state the character of same and depth placed, from feet to feet for each plug set.

Hole was filled with heave rotary mud from bottom to 150 ft.
Plug down at 270 ft. Fifteen sacks of cement on top of plug then filled with heavy rotary mud to 30 ft. and top plug set at 30 ft. with 10 sacks of cement on top of plug to surface.

(If additional description is necessary, use BACK of this sheet)

Name of Plugging Contractor Hilton Drilling Company, Inc.
Address Box 164 Great Bend, Kansas

STATE OF Kansas COUNTY OF Barton ss.
Henry Peacock (employee of owner) or (owner or operator) of the above-described well,

being first duly sworn on oath, says: That I have knowledge of the facts, statements, and matters herein contained and the log of the above-described well as filed, and that the same are true and correct. So help me God.

(Signature) *Henry Peacock*
Great Bend, Kansas
(Address)

SUBSCRIBED AND SWORN to before me this 10th day of April, 1952
Geo. H. Clark
Notary Public.

My commission expires Sept. 20, 1954

PLUGGING
FILE SEC 6 T 20 R 12
BOOK PAGE 7 LINE 8

4-11-52

D R I L L E R ' S L O G

COMPANY: HILTON DRILLING COMPANY, INC., ET AL
CONTRACTOR: HILTON DRILLING COMPANY, INC.
FARM NAME: BIRZER NO. 1
COMMENCED: 3-24-52
COMPLETED: 4-6-52

LOCATION: NE SE NE 6-20-12
Barton County, Kansas
ELEVATION: 1324 DF

CASING USED: 8 5/8" at 157' with 180 sacks

Sand and Gravel	95
Hard Sand and Iron	125
Iron and Sand	145
Shale and Shells	164
Hard Sand, Iron and Shale	260
Sand and Shale	280
Red Bed	645
Anhydrite	670
Red Bed, Shale and Shells	1095
Shale, Shells and Salt	1525
Lime	1760
Sand	1775
Lime and Shale	2230
Shale and Broken Lime	2395
Shale and Lime	2725
Lime	2988
Lime and Shale	3173
Lime	3393
Conglomerate	3432
Total Depth	3432

STATE OF KANSAS)
) SS
COUNTY OF BARTON)

I, the undersigned, being duly sworn on oath, state that the above statement and log are true and a correct record and log of the well drilled at the location above described.

HILTON DRILLING COMPANY, INC.

E. M. Hilton
By _____
President

Subscribed and sworn to before me this 9th day of April, 1952.

Henry Peacock

Notary Public

My commission expires June 13, 1955. APR 11 1952

PLUGGING
FILE SEC 67-20R180
BOOK PAGE 7 LINE 8