


WELL PLUGGING RECORD

Give All Information Completely
Make Required Affidavit
Mail or Deliver Report to:
Conservation Division
State Corporation Commission
211 No. Broadway
Wichita, Kansas

Barton County, Sec. 6 Twp. 20S Rge. 12 (E) W (W)

Location as "NE/CNW/SW" or footage from lines SW SE SE
Lease Owner: Flournoy & Forbes
Lease Name Dodge Well No. 2
Office Address P.O. Box 270, Hoisington, Kansas
Character of Well (completed as Oil, Gas or Dry Hole) Dry Hole
Date well completed August 19, 1957
Application for plugging filed August 19, 1957
Application for plugging approved August 19, 1957
Plugging commenced August 19, 1957
Plugging completed August 19, 1957
Reason for abandonment of well or producing formation Dry Hole

NORTH

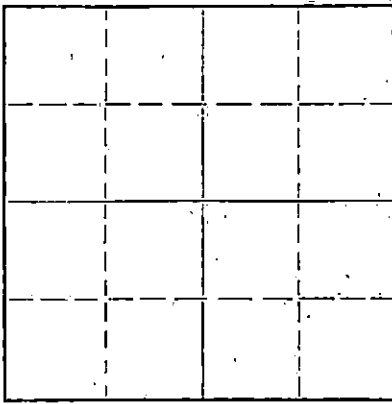

Locate well correctly on above
Section Plat

If a producing well is abandoned, date of last production _____ 19____
Was permission obtained from the Conservation Division or its agents before plugging was commenced? Yes

Name of Conservation Agent who supervised plugging of this well R. M. Brundage
Producing formation _____ Depth to top _____ Bottom _____ Total Depth of Well 3461 Feet
Show depth and thickness of all water, oil and gas formations.


OIL, GAS OR WATER RECORDS

CASING RECORD

FORMATION	CONTENT	FROM	TO	SIZE	PUT IN	PULLED OUT
		0	285	8 5/8"	285'	none

Describe in detail the manner in which the well was plugged, indicating where the mud fluid was placed and the method or methods used in introducing it into the hole. If cement or other plugs were used, state the character of same and depth placed, from _____ feet to _____ feet for each plug set.

From 3461' to 210' - heavy rotary mud
210' to 147' - plug, 1/2 sack hulls and 20 sacks cement
147' to 30' - heavy rotary mud
30' to 6' - plug, 1/2 sack hulls and 5 sacks cement
6' to surface - cellar

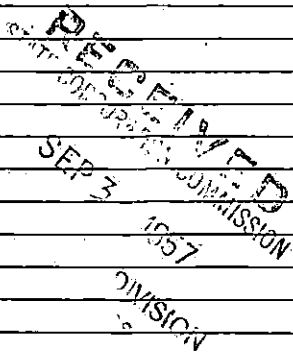

9-3-57

(If additional description is necessary, use BACK of this sheet)

Name of Plugging Contractor Peel Brothers, Inc.
Address P.O. Box 88, Hoisington, Kansas

STATE OF KANSAS, COUNTY OF BARTON, ss.
Peel Brothers, Inc. (employee of owner) or (owner/operator) of the above-described well, being first duly sworn on oath, says: That I have knowledge of the facts, statements, and matters herein contained and the log of the above-described well as filed and that the same are true and correct. So help me God. PEEL BROTHERS, INC.

(Signature) By: Al H. Smith
P.O. Box 88, Hoisington, Kansas
(Address)

SUBSCRIBED AND SWORN to before me this 27th day of August, 19 57

Ruth Brank
Notary Public.

My commission expires April 27, 1960

PLUGGING
FILE SEC 6 T 20 R 12W
BOOK PAGE 38 LINE 43

DRILLERS' LOG

Company: Vlourney & Forbes

SW SE SE

Sec. 6, Twp. 20S, Rge. 12W,

Farm Name: Dodge Well No. 2

County: Barton,

Total Depth: 3461'

Kansas

Comm: 8/7/57 Comp: 3/19/57

Elevation:

Contractor: Pool Brothers, Inc.

Production: Dry

Casing: 3 5/8" @ 235' con.

Figures below indicate bottoms of formations:

Surface sand	0 -	120
Hard sand		190
Shale		235
Shale and red bed		675
Sand and shale		710
Shale and shells		765
Shale		1000
Shale and shells		1750
Lime and shale		2205
Shale		2455
Shale and lime		2925
Lime		2953
Lime and shale		3202
Lime		3233
Lime and shale		3285
Lime		3427
Lime and chert		3456
Lime		3461
Total Depth		3461

This is to certify that the above information is to the best of our knowledge, true and correct.

POOL BROTHERS, INC.

BY: Al H. SmithSUBSCRIBED AND SWORN to before me this 27th day of August, 1957

My commission expires: April 27, 1960

Ruth Brink
Notary Public

RECEIVED
STATE CORPORATION COMMISSION

AUG 29 1957

CONSERVATION DIVISION
Wichita, Kansas

PLUGGING
FILE SEC. 6 T. 20 R. 12W
BOOK PAGE 30 LINE 43