


Give All Information Completely  
Make Required Affidavit  
Mail or Deliver Report to:  
Conservation Division  
State Corporation Commission  
211 No. Broadway  
Wichita, Kansas

WELL PLUGGING RECORD

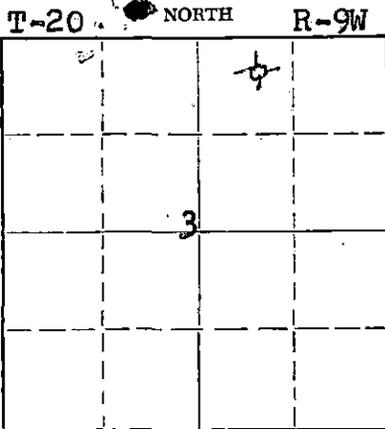

Locate well correctly on above Section Plat.

Rice County, Sec. 3 Twp. 20 Rge. (E) 9W  
 Location as "NE/CNW%SW%" or footage from lines C NE NW NE  
 Lease Owner Donald T. Ingling et al  
 Lease Name Speck Well No. 1  
 Office Address 615 First Nat'l Bank Bldg., Wichita 2, Kans.  
 Character of Well (completed as Oil, Gas or Dry Hole) Dry Hole  
 Date well completed June 26, 19 60  
 Application for plugging filed June 26, 19 60  
 Application for plugging approved June 26, 19 60  
 Plugging commenced June 26, 19 60  
 Plugging completed June 26, 19 60  
 Reason for abandonment of well or producing formation dry

If a producing well is abandoned, date of last production 19  
 Was permission obtained from the Conservation Division or its agents before plugging was commenced? Yes

Name of Conservation Agent who supervised plugging of this well Gilbert Toman  
 Producing formation \_\_\_\_\_ Depth to top \_\_\_\_\_ Bottom \_\_\_\_\_ Total Depth of Well 3275 Feet  
 Show depth and thickness of all water, oil and gas formations.

OIL, GAS OR WATER RECORDS

CASING RECORD

FORMATION	CONTENT	FROM	TO	SIZE	PUT IN	PULLED OUT
				8 5/8"	203	None

Describe in detail the manner in which the well was plugged, indicating where the mud fluid was placed and the method or methods used in introducing it into the hole. If cement or other plugs were used, state the character of same and depth placed, from \_\_\_\_\_ feet to \_\_\_\_\_ feet for each plug set.

Plugged hole to 190 feet - set bottom plug, then 20 sacks cement through drill pipe - filled hole with heavy mud - set rock bridge at 40 feet, then 10 sacks cement and 3 sacks cement in rathole. Plugging completed.

RECEIVED  
STATE CORPORATION COMMISSION

JUL 27 1960 7-27-60

CONSERVATION DIVISION  
Wichita, Kansas

(If additional description is necessary, use BACK of this sheet)  
 Name of Plugging Contractor Donald T. Ingling  
 Address 615 First Nat'l Bank Bldg., Wichita 2, Kansas

STATE OF KANSAS, COUNTY OF SEDGWICK, ss.  
D. T. Ingling (employee of owner) or (owner or operator) of the above-described well, being first duly sworn on oath, says: That I have knowledge of the facts, statements, and matters herein contained and the log of the above-described well as filed and that the same are true and correct. So help me God.

(Signature) D. T. Ingling  
615 First Nat'l Bank Bldg., Wichita 2,  
 (Address)

SUBSCRIBED AND SWORN TO before me this 28th day of June, 19 60

My commission expires Feb 27, 1964  
W. E. Black Notary Public.

Donald T. Ingling et al, Lease Owner

Section 3-20-9W

Donald T. Ingling, Contractor

Location: C NE NW NE

Commenced: 6-17-60

County: Rice

Completed: 6-26-60

Production: Dry

Total Depth: 3275'

Elevation: 1681 RB

Casing: 8 5/8" 203' (100 sacks cement)

Figures below indicate bottom formation.

90	surface cland and sand	3255	Arbuckle
170	red rock and clay	3275	Arbuckle
203	shale and shells	3275	Total Depth
290	shale and red rock		
310	lime		
410	red rock and shale		
800	shale		
1080	salt		
1095	shale		
1265	lime and shale streaks		
1475	lime and shale		
1645	lime and shale		
1773	lime		
1880	shale and lime streaks		
2110	shale and lime streaks		
2265	shale and lime		
2390	lime and shale		
2445	lime and shale		
2550	lime		
2605	lime		
2690	lime		
2710	lime		
2840	shale and sand		
2843	shale		
2846	lime - Brown		
2872	shale		
2945	lime - Lansing		
3010	lime		
3055	lime		
3130	lime		
3194	lime		
3200	Conglomerate		
3236	Conglomerate		

STATE OF KANSAS  
 JUL 27 1960  
 CONSERVATION DIVISION  
 Wichita, Kansas

I certify this is a true and correct copy of the above mentioned well.

STATE OF KANSAS )  
                          ) SS.  
SEDGWICK COUNTY )

Donald T. Ingling

Subscribed and sworn to before me, a Notary Public, in said county and state.

M.E. Beach  
Notary Public

My commission expires: Feb. 27, 1964