


WELL PLUGGING RECORD

Give All Information Completely
Make Required Affidavit
Mail or Deliver Report to:
Conservation Division
State Corporation Commission
212 No. Market
Wichita, Kansas

NORTH

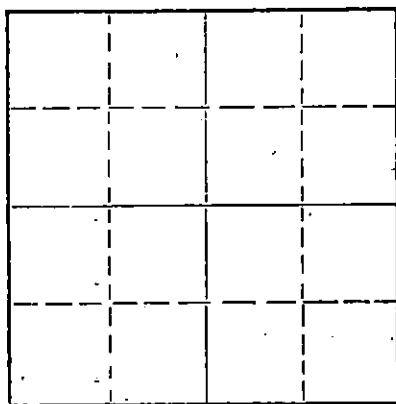

Locate well correctly on above
Section Plat

Rice County, Sec. 2 Twp. 20S Rge. (E) 9W (W)
Location as "NE/CNW*SW*" or footage from lines NE NE SE
Lease Owner Raymond Oil Company, Inc.
Lease Name Father Flanagan's Boys' Home Well No. 1
Office Address 410 Fourth Nat'l Bank Bldg., Wichita, Kansas
Character of Well (completed as Oil, Gas or Dry Hole) Dry Hole
Date well completed January 31, 19 68
Application for plugging filed 19
Application for plugging approved 19
Plugging commenced January 31, 19 68
Plugging completed January 31, 19 68
Reason for abandonment of well or producing formation Dry Hole

If a producing well is abandoned, date of last production 19
Was permission obtained from the Conservation Division or its agents before plugging was com-
menced? Yes (Gilbert Toman)

Name of Conservation Agent who supervised plugging of this well
Producing formation Depth to top Bottom Total Depth of Well 3410 Feet
Show depth and thickness of all water, oil and gas formations.

OIL, GAS OR WATER RECORDS

CASING RECORD

FORMATION	CONTENT	FROM	TO	SIZE	PUT IN	PULLED OUT
	Surface	0	285'	8-5/8"	1/25/68	-----
	Casing					

Describe in detail the manner in which the well was plugged, indicating where the mud fluid was placed and the method or methods used in introducing it into the hole. If cement or other plugs were used, state the character of same and depth placed, from feet to feet for each plug set.

Heavy Mud from Total Depth to 275 Feet; Hulls, Plug and 25 sax Cement thru the Drill Pipe; Heavy Mud to 40 Feet; 1/2 sax Hulls, Plug bridged with Kelly and 10 sax Cement to Base of Cellar; 2 sax Cement in Rat Hole. Job completed @ 3:30 A.M.


RECEIVED
STATE CORPORATION COMMISSION
FEB 6 - 1968
CONSERVATION DIVISION
Wichita, Kansas

(If additional description is necessary, use BACK of this sheet)
Name of Plugging Contractor Sage Drilling Co., Inc.
Address 500 Bitting Building, Wichita, Kansas

STATE OF KANSAS, COUNTY OF SEDGWICK, ss.
T. M. McCaul, Jr. of Sage Drilling Co. (Employee of owner) or (owner or operator) of the above described well, being first duly sworn on oath, says: That I have knowledge of the facts, statements, and matters herein contained and the log of the above described well as filed and that the same are true and correct. So help me God.

(Signature) [Signature]
500 Bitting Building, Wichita, Ks.
(Address)

SUBSCRIBED AND SWORN to before me this 5th day of February 19 68
My commission expires November 26, 1970.
Louise K. Whitted - Notary Public.

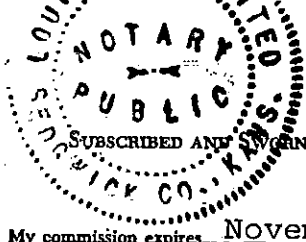

DRILLERS LOG

FATHER FLANAGAN'S BOYS' HOME NO. 1

CASING RECORD:	COMPANY: Raymond Oil Company	DESCRIPTION:
8-5/8" @ 285' w/200 sax. Cement	CONTRACTOR: Sage Drilling Co.	NE NE SE Sec. 2-20S-9W Rice County, Kansas
TOTAL DEPTH: 3410'	COMMENCED: January 25, 1968	ELEVATION: 1709KB
	COMPLETED: January 31, 1968	

<u>FORMATION</u>	<u>FROM</u>	<u>TO</u>	<u>REMARKS</u>
Surface Soil & Sand	0	286	
Red Bed, Shale & Sand	286	532	
Anhydrite	532	560	
Shale & Shells	560	1440	
Lime & Shale	1440	2750	
Shale & Lime	2750	2965	
Lime & Shale	2965	3080	
Lime	3080	3190	
Lime & Shale	3190	3410	D&A

RECEIVED
STATE CORPORATION COMMISSION
FEB 6 - 1968
CONSERVATION DIVISION
Wichita, Kansas

I certify that this is a true and correct copy of the above log to the best of my knowledge.

SAGE DRILLING CO., INC.

By *T. M. McCaul, Jr.*
T. M. McCaul, Jr.

Subscribed and sworn to before me this 5th day of February, 1968.

Louise K. Whitted
Louise K. Whitted, Notary Public

My commission expires:
November 26, 1970.