


WELL PLUGGING RECORD

Give All Information Completely
Make Required Affidavit
Mail or Deliver Report to:
Conservation Division,
State Corporation Commission
211 No. Broadway
Wichita, Kansas

NORTH

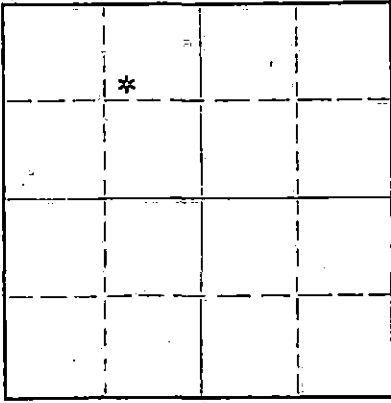

Locate well correctly on above
Section Plat

Rice County, Sec. 9 Twp. 20 Rge. 10 (E) W (W)

Location as "NE/CNW/SW" or footage from lines C SW NE NW
Lease Owner Bea Drilling Co., Inc., et al
Lease Name Schubert Well No. 1
Office Address Box 247, Ellinwood, Kansas
Character of Well (completed as Oil, Gas or Dry Hole) Dry hole
Date well completed 12/23/61 19
Application for plugging filed Verbally 12/22/61 19
Application for plugging approved Verbally 12/22/61 19
Plugging commenced 12/22/61 19
Plugging completed 12/23/61 @ 2 A.M. 19
Reason for abandonment of well or producing formation _____

If a producing well is abandoned, date of last production _____ 19
Was permission obtained from the Conservation Division or its agents before plugging was commenced? Yes

Name of Conservation Agent who supervised plugging of this well Cecil Jones, McPherson, Kansas
Producing formation _____ Depth to top _____ Bottom _____ Total Depth of Well 3420 Feet
Show depth and thickness of all water, oil and gas formations.

OIL, GAS OR WATER RECORDS

CASING RECORD

FORMATION	CONTENT	FROM	TO	SIZE	PUT IN	PULLED OUT
		0	215	8 5/8"	215	None

Describe in detail the manner in which the well was plugged, indicating where the mud fluid was placed and the method or methods used in introducing it into the hole. If cement or other plugs were used, state the character of same and depth placed, from _____ feet to _____ feet for each plug set.

Hole filled w/ heavy mud 3420 to 181'
Set plug @180' plus 1/2 sack hulls
Run 20 sacks cement
Filled hole w/ mud to 36'
Set plug @35' plus 1/2 sack hulls
Run 8 sacks cement to bottom of cellar.
Run 2 sacks cement in rathole, filled w/ soil to surface.

STATE CORPORATION COMMISSION
JAN 2 1962
CONSERVATION DIVISION

(If additional description is necessary, use BACK of this sheet.)
Name of Plugging Contractor Bea Drilling Co., Inc.
Address Box 247, Ellinwood, Kansas

STATE OF Kansas, COUNTY OF Barton, ss.
C. F. Krehbiel (employee of owner) or (owner or operator) of the above-described well, being first duly sworn on oath, says: That I have knowledge of the facts, statements, and matters herein contained and the log of the above-described well as filed and that the same are true and correct. So help me God.

(Signature) C. F. Krehbiel
Box 247, Ellinwood, Kansas (Address)

SUBSCRIBED AND SWORN TO before me this 29th day of December, 1961
Thelma S. Ash
My commission expires November 15, 1962 Notary Public.

W E L L L O G

Bea Drilling Co., Inc., et al
 # 1 Schubert
 SW NE NW Section 9-20S-10W
 Rice County, Kansas

Date Staked : 12/7/61
 Date Started: 12/8/61
 Set Surface : 12/14/61
 Completed : 12/23/61

Elevation GL 1805 KB 1811'

Formation Tops:

Casing record: 215.48' (11 jts)
 of 8 5/8" casing cemented w/135
 sacks cement, 1 aquagel, 1 c c.
 Circulated w/20' in csg. 12/15

Heebner	2942	-1131
Brown lime	3066	-1255
Lansing-Kansas City	3094	-1283
Conglomerate	3368	-1557
Simpson sand	3376	-1565
Arbuckle	3420	-1600
		-1591
Total Depth	3420	-1609

DRILL STEM TEST; 3348-3382, Open 1 hr. 20 min IBHP 276#, 20 min FBHP
 89#, IFP 48 #, FFP 48 #. Recovery: No blow, 25' of mud.

Drillers Log

(All measurements to bottom of formations.)

Sand & clay	90
Shale & shells	160
Shells & shale	210
Shale	490
Anhydrite	520
Shale & shells	1490
Shale & lime	1550
Lime & shale	1790
Sandy lime & shale	1890
Lime & shale	2150
Shale & shells	2430
Shale & lime	2780
Lime	2834
Lime & shale	2920
Shale & lime	3065
Lime	3140
Lime & shale	3260
Lime	3335
Lime - shale	3382
Lime	3420
Rotary Total Depth	3420

JAN 2 1962


I hereby certify that the above is a true and correct log of said well as reflected by the daily drilling reports.

C. F. Krehbiel
 C. F. Krehbiel

STATE OF KANSAS)
) SS
 COUNTY OF BARTON)

Subscribed and sworn to before me this 29th day of December, 1961

Helma L. Ash
 Notary Public

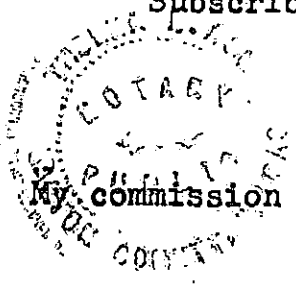

My commission expires November 15, 1962.