


WELL PLUGGING RECORD

Give All Information Completely  
Make Required Affidavit  
Mail or Deliver Report to:  
Conservation Division  
State Corporation Commission  
800 Bittling Building  
Wichita, Kansas

Rice

County. Sec. 36 Twp. 20 Rge. SW (E) (W)

Location as "NE/CNW/4SW/4" or footage from lines NECNE SW  
 Lease Owner Carlock, Incorporated  
 Lease Name Walton Well No. 1  
 Office Address 1511 Apco Tower, Oklahoma City 2, Oklahoma  
 Character of Well (completed as Oil, Gas or Dry Hole) Dry Hole  
 Date well completed December 31, 19 48  
 Application for plugging filed December 31, (verbal) 19 48  
 Application for plugging approved January 4, 19 49  
 Plugging commenced December 31, 19 48  
 Plugging completed January 3, 19 49  
 Reason for abandonment of well or producing formation Dry Hole

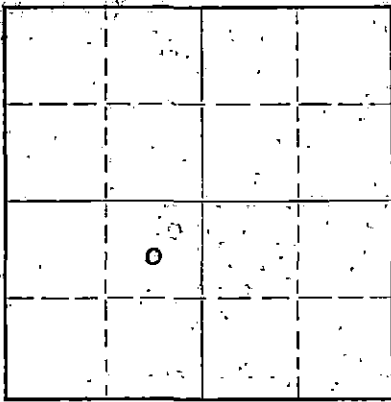

Locate well correctly on above Section Plat

If a producing well is abandoned, date of last production none 19  
 Was permission obtained from the Conservation Division or its agents before plugging was commenced? Yes

Name of Conservation Agent who supervised plugging of this well Ruel Durkee  
 Producing formation none Depth to top 3348 Bottom 3375 Total Depth of Well 3375 Feet  
 Show depth and thickness of all water, oil and gas formations.

OIL, GAS OR WATER RECORDS

CASING RECORD

Formation	Content	From	To	Size	Put In	Pulled Out
				8-5/8"	130'	

Describe in detail the manner in which the well was plugged, indicating where the mud fluid was placed and the method or methods used in introducing it into the hole. If cement or other plugs were used, state the character of same and depth placed, from \_\_\_\_\_ feet to \_\_\_\_\_ feet for each plug set.

130 feet of 8 5/8" casing cemented with 130 sacks of cement and 1 sack of calcium chloride.  
 Hole filled with heavy rotary mud and 15 sacks of cement spotted at 130 feet. 5 sacks of cement at top of surface pipe.

FEB 2 - 1949 2-2-1949  
 CURTIS DIVISION  
 KANSAS

(If additional description is necessary, use BACK of this sheet)  
 Correspondence regarding this well should be addressed to Carlock, Incorporated  
 Address 1511 Apco Tower,  
Oklahoma City 2, Oklahoma

STATE OF Oklahoma, COUNTY OF Oklahoma, ss.  
Carlock, Incorporated (employee of owner) or (owner or operator) of the above-described well,

being first duly sworn on oath, says: That I have knowledge of the facts, statements, and matters herein contained and the log of the above-described well as filed and that the same are true and correct. So help me God.

By Carlock, Incorporated  
 (Signature) [Signature]  
 President.

1511 Apco Tower, Okla. City, Okla.  
 (Address)

SUBSCRIBED AND SWORN to before me this 29 day of January, 19 49

My commission expires Feb. 22, 1951  
[Signature] Notary Public.

*Carlock, Inc.*

15.159.03729.0000

Farm Walton # 1  
C-Ten Acres NE 1/4  
SW 1/4 - S c-36 - 20-8-W  
Rice County.  
Carlock, Inc.

0-	75	Sand & Clay.
75 -	130	Red rock & shale.
130	295	- Shale.
295	1090	- Shale & shells
1090	1215	- Lime & shells
1215	1340	- shale & lime
1340	1465	- shale & lime
1465	1528	- Lime
1528	1628	- Lime & shale
1628	1758	- Lime
1758	2170	- Lime & shale
2170	2540	- Lime
2540	2665	- Lime & shale.
2665	2740	- Lime Broken
2740	2885	- Lime.
2885	2965	- Lime & shale.
2985	3285	- Lime
3285	3330	- Shale & lime.
3330	3337	- Chert - Conglomert
3337	3349	- shale
3349	3352	- Various colored shale.
3352	3358	- shale
3358	3377	- shale. Total Depth - Dry

NB.- 130' Surface -85-8" -80 sacks cement-1-calcium.

RECEIVED

JAN 29 1944

STATE

CO.

**PLUGGING**  
 FILE SEC 36 T 20 R 2d  
 BOOK PAGE 78 LINE 6