

TYPE

AFFIDAVIT OF COMPLETION FORM

ACO-1 WELL HISTORY

Compt. _____

SIDE ONE

Two (2) copies of this form shall be filed with the Kansas Corporation Commission, 200 Colorado Derby Building, Wichita, Kansas 67202, within thirty (30) days after the completion of a well, regardless of how the well was completed.

F Attach separate letter of request if the information is to be held confidential. If confidential, only file one copy. Information on Side One will be of public record and Side Two will then be held confidential.

Applications must be made on dual completion, commingling, salt water disposal, injection and temporarily abandoned wells:

C Attach one copy only wireline logs (i.e. electrical log, sonic log, gamma ray, neutron log, etc.). (Rules 82-2-105 & 82-2-125) KCC# (316) 263-3238.

LICENSE # 7861 EXPIRATION DATE June 30 yearly

OPERATOR WESX Petroleum Inc. API NO. 15-009-23,005

ADDRESS P.O. Box 1609, Great Bend, Kansas 67530 COUNTY Barton

FIELD

** CONTACT PERSON Milford Martin PROD. FORMATION --
PHONE 316-792-7323

PURCHASER -- LEASE Weathers

ADDRESS WELL NO. 1

WELL LOCATION NE NW SE

DRILLING CONTRACTOR Mustang Drilling & Exploration, Inc. 330 Ft. from North Line and

ADDRESS P.O. Box 1609 990 Ft. from West Line of


Great Bend, Kansas 67530 the SE(Qtr.) SEC 18 TWP 20 S RGE 13 (W).

PLUGGING CONTRACTOR Mustang Drilling & Exploration, Inc.

ADDRESS P.O. Box 1609

Great Bend, Kansas 67530

WELL PLAT (Office Use Only)

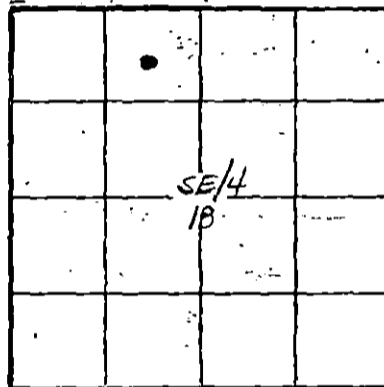

KCC
KGS
SWD/REP
PLG.

TOTAL DEPTH 3558' PBD

SPUD DATE 3-12-83 DATE COMPLETED 3-19-83

ELEV.: GR 1876 DF 1878 KB 1881

DRILLED WITH (CABLE) (ROTARY) (AIR) TOOLS.

DOCKET NO. OF DISPOSAL OR REPRESSURING WELL BEING USED TO DISPOSE OF WATER FROM THIS LEASE

Amount of surface pipe set and cemented 556 DV Tool Used?

THIS AFFIDAVIT APPLIES TO: (Circle ONE) - Oil, Gas, Shut-in Gas, (Dry) Disposal, Injection, Temporarily Abandoned, OWWO. Other

ALL REQUIREMENTS OF THE STATUTES, RULES AND REGULATIONS PROMULGATED TO REGULATE THE OIL AND GAS INDUSTRY HAVE BEEN FULLY COMPLIED WITH.

A F F I D A V I T


Gib Overbey, being of lawful age, hereby certifies that:

I am the Affiant, and I am familiar with the contents of the foregoing Affidavit. The statements and allegations contained therein are true and correct.

Gib Overbey
(Name)

SUBSCRIBED AND SWORN TO BEFORE ME this 30th day of March

19 83

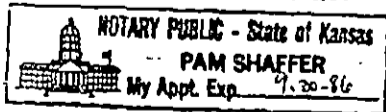

Pam Shaffer
(NOTARY PUBLIC)

MY COMMISSION EXPIRES: 9-30-86

** The person who can be reached by phone regarding any questions concerning this information.

*** IF HOLE IS PLUGGED A THIRD COPY IS NEEDED. FOR INJECTION OR DISPOSAL FOUR COPIES ARE NEEDED.

RECEIVED STATE CORPORATION COMMISSION

APR 01 1983

CONSERVATION DIVISION
Wichita, Kansas