


STATE OF KANSAS  
STATE CORPORATION COMMISSION

WELL PLUGGING RECORD

Give All Information Completely  
Make Required Affidavit  
Mail or Deliver Report to:  
Conservation Division  
State Corporation Commission  
212 North Market, Insurance Bldg.  
Wichita, Kansas

NORTH

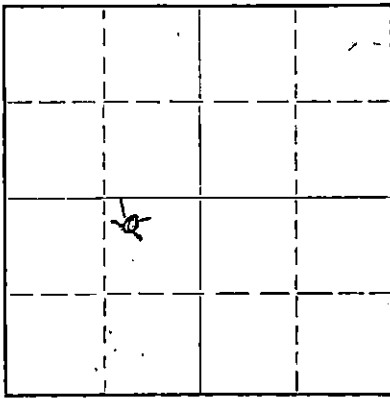

Locate well correctly on above  
Section Plat

Mc Pherson County, Sec. 16 Twp. 20 Rge. 1 (#) (W)  
Location as "NE/CNW/SW" or footage from lines NW NE SW  
Lease Owner P.E. Plouffe--H. J. Plouffe  
Lease Name Wogts Well No. 1  
Office Address Canton, Kansas  
Character of Well (completed as Oil, Gas or Dry Hole) Dry hole  
Date well completed September 23 19 59  
Application for plugging filed " " 19 " "  
Application for plugging approved " oral 19 " "  
Plugging commenced " " 19 " "  
Plugging completed " " 19 " "  
Reason for abandonment of well or producing formation \_\_\_\_\_

If a producing well is abandoned, date of last production \_\_\_\_\_ 19 \_\_\_\_\_  
Was permission obtained from the Conservation Division or its agents before plugging was commenced? yes--oral

Name of Conservation Agent who supervised plugging of this well Cecil Jones, Mc Pherson, Kansas  
Producing formation \_\_\_\_\_ Depth to top \_\_\_\_\_ Bottom \_\_\_\_\_ Total Depth of Well 3008 Feet  
Show depth and thickness of all water, oil and gas formations.

OIL, GAS OR WATER RECORDS

CASING RECORD

FORMATION	CONTENT	FROM	TO	SIZE	PUT IN	PULLED OUT
					167'	none

Describe in detail the manner in which the well was plugged, indicating where the mud fluid was placed and the method or methods used in introducing it into the hole. If cement or other plugs were used, state the character of same and depth placed, from \_\_\_\_\_ feet to \_\_\_\_\_ feet for each plug set.

Filled hole full of heavy mud to 167 ft.  
Drove wooden plug to 167 ft, and dumped in  
13 sacks cement.  
Finished filling hole full heavy mud to within 40 ft of  
cellar and dumped in 10 sacks cement, 2 sacks in rat hole.

RECEIVED  
STATE CORPORATION COMMISSION

SEP 29 1959

CONSERVATION DIVISION  
Wichita, Kansas

(If additional description is necessary, use BACK of this sheet)

Name of Plugging Contractor Mallard Drilling Company  
Address 419 Union National Bldg.

STATE OF Kansas, COUNTY OF Sedgwick, ss.  
C. C. Nelson, partner Mallard Drg. (employee of owner) for (owner or operator) of the above-described well, being first duly sworn on oath, says: That I have knowledge of the facts, statements, and matters herein contained and the log of the above-described well as filed and that the same are true and correct. So help me God.

(Signature) C. C. Nelson  
419 Union National Bldg.  
(Address)

SUBSCRIBED AND SWORN TO before me this 28th day of September, 19 59

My commission expires March 27, 1962  
Edward V. Sage  
Notary Public.



COMPANY: P.E. Plouffe--H.J. Plouffe  
 CONTRACTOR: Mallard Drilling Company  
 FARM: Vogts #1  
 LOCATION: NW NE SW Sec. 16-20-1W  
 Mc Pherson County, Kansas  
 COMMENCED: September 17, 1959  
 COMPLETED: September 23, 1959

0	to	50	Shale
50	to	90	Sand
90	to	167	Shale
167	to	510	Shale and lime
510	to	700	Lime
700	to	965	Lime
965	to	1180	Lime and shale
1180	to	1580	Shale and lime
1580	to	2145	Shale and lime
2145	to	2340	Shale and lime
2340	to	2630	Lime
2630	to	2938	Shale and lime
2938	to	2985	Mississippi
2986	to	3008	Mississippi
		3008	T.D. Rotary

\*\*\*\*

Set 167 feet of 8 5/8" surface pipe. Cemented with 110 sacks cement.

TOPS; Mississippi -- 2922

Measurements taken from R.D.B. R.D.B. 5 1/2 ft from ground level. SEP 29 1959

DRY, ABANDONED AND PLUGGED

RECEIVED  
STATE CORPORATION COMMISSION

CONSERVATION DIVISION  
Wichita, Kansas

C E R T I F I C A T E

I, C. C. Nelson, do hereby certify that the above and foregoing is a true and correct copy of log of the Vogts #1, Mc Pherson, County, Kansas, as reflected by files of the Mallard Drilling Company.

*C. C. Nelson*

Subscribed and sworn to before me a Notary Public, within and for Sedgwick County, Kansas, this 28th day of September 1959.

*Edward V. Sage*

My commission expires March 22, 1962

