


WELL PLUGGING RECORD

Give All Information Completely
Make Required Affidavit
Mail or Deliver Report to:
Conservation Division
State Corporation Commission
800 Biffing Building
Wichita, Kansas

NORTH

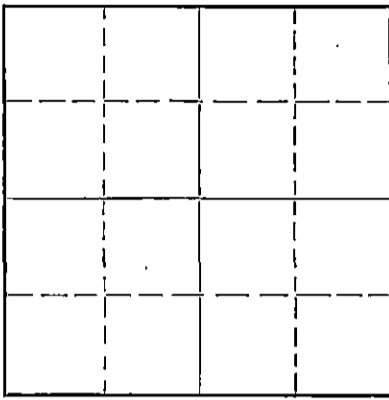

Locate well correctly on above
Section Plat

McPherson County. Sec. 16 Twp. 20 Rge. 1 (E) W (W)
Location as "NE/CNW $\frac{1}{4}$ SW $\frac{1}{4}$ " or footage from lines NW, NW, NW.
Lease Owner National Cooperative Refinery
Lease Name Kuhlmeir Well No. 1
Office Address Union National Bank Bldg., Wichita, Kansas
Character of Well (completed as Oil, Gas or Dry Hole) Dry hole
Date well completed November 6, 19 50
Application for plugging filed November 6, 19 50
Application for plugging approved November 6, 19 50
Plugging commenced November 6, 19 50
Plugging completed November 6, 19 50
Reason for abandonment of well or producing formation dry hole

If a producing well is abandoned, date of last production 19...
Was permission obtained from the Conservation Division or its agents before plugging was commenced? yes

Name of Conservation Agent who supervised plugging of this well Ruel Durkee
Producing formation Depth to top Bottom Total Depth of Well 315 Feet
Show depth and thickness of all water, oil and gas formations.

OIL, GAS OR WATER RECORDS

CASING RECORD

Formation	Content	From	To	Size	Put In	Pulled Out
				8-5/8"	124 ft	none

Describe in detail the manner in which the well was plugged, indicating where the mud fluid was placed and the method or methods used in introducing it into the hole. If cement or other plugs were used, state the character of same and depth placed, from top feet to bottom feet for each plug set.

mud to 124 feet set plug with
15 sacks of cement; mud to 30 feet,
set plug and dump 5 sacks of cement
complete

(If additional description is necessary, use BACK of this sheet)


Correspondence regarding this well should be addressed to National Cooperative Refinery Assn.
Address Union National Bank Bldg., Wichita, Kansas

STATE OF KANSAS, COUNTY OF SEDGWICK, ss.
Heber Beardmore (employee of owner) of the above-described well,
being first duly sworn on oath, says: That I have knowledge of the facts, statements, and matters herein contained and the log of the above-described well as filed and that the same are true and correct. So help me God.

(Signature) BEARDMORE DRILLING COMPANY
By Heber Beardmore
603 Petroleum Bldg., Wichita, Kansas

SUBSCRIBED AND SWORN TO before me this 20th day of November, 19 50

My commission expires October 12, 1952.

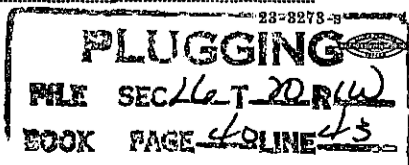

Notary Public. Murray
10V 21 1950
COMMISSION
CONSERVATION DIVISION
Wichita, Kansas
11-21-1950

Kuhlmeir No. 1 Well

15.113.01884.0000

NW, NW, NW,
Section 16-20S-1W,
McPherson County, Kansas

Drilled for: National Coop. Refinery
Drilled by: Beardmore Drilling Company

Casing Record:

8-5/8" 124' w/100 sacks

Drilling Commenced: October 25, 1950
Drilling Completed: November 6, 1950

FORMATION	DEPTH
Soil - sand	20
Sand	75
Shale - shells	300
Lime - shale	475
Hard sandy lime	590
Shale - lime	650
Lime - shale	1135
Shale - lime	1825
Lime - shale	2010
Shale - lime	2097
Sandy shale	2235
Lime - shale	2295
Shale - lime	2520
Lime - shale	2610
Shale - lime	2935
Lime	2970
Lime - chert	2990
Lime	3020
Lime - chert	3110
Lime - shale	3145
Shale	3245
Shale	3401
Shale - lime	3415 T.D.

D & A

Top of Viola 3412

STATE OF KANSAS

ss

COUNTY OF SEDGWICK

I, the undersigned, being duly sworn on oath state that the above and within statement is a true and correct record and log of the well drilled on the location above-described to the best of my knowledge and belief.

W. H. Beardmore

Subscribed and sworn to before me this 16th day of November, 1950

Echel Murray

Notary Public

My Commission Expires: Oct. 11, 1952.

REIVED
CORPORATION COMMISSION
NOV 21 1950
CONSERVATION DIVISION
Wichita, Kansas

PLUGGING
FILE SEC 16-20-1W
BOOK PAGE 46 LINE 43

Kuhlmeir No. 1 Well

NW, NW, NW,
Section 16-208-1W,
McPherson County, Kansas

Drilled for: National Coop. Refinery
Drilled by: Beardmore Drilling Company

Casing Record:

8-5/8" 12h' w/100 sacks

Drilling Commenced: October 25, 1950
Drilling Completed: November 6, 1950

FORMATION	DEPTH
Soil - sand	20
Sand	75
Shale - shells	300
Line - shale	475
Hard sandy line	590
Shale - line	650
Line - shale	1135
Shale - line	1825
Line - shale	2010
Shale - line	2097
Sandy shale	2235
Line - shale	2295
Shale - line	2520
Line - shale	2610
Shale - line	2935
Line	2970
Line - chert	2990
Line	3020
Line - chert	3110
Line - shale	3145
Shale	3245
Shale	3401
Shale - line	3415 T.D.

D & A

Top of Viola 3412

STATE OF KANSAS

COUNTY OF SEDGWICK

I, the undersigned, being duly sworn on oath state that the above and within statement is a true and correct record and log of the well drilled on the location above-described to the best of my knowledge and belief.

W. H. Beardmore

Subscribed and sworn to before me this 15th day of November, 1950

RECEIVED
STATE CORPORATION COMMISSION
NOV 21 1950
Notary Public
CONSERVATION DIVISION
Wichita, Kansas

My Commission Expires: Oct. 11, 1952.