


WELL PLUGGING RECORD

Give All Information Completely  
Make Required Affidavit  
Mail or Deliver Report to:  
Conservation Division  
State Corporation Commission  
212 No. Market  
Wichita, Kansas

NORTH

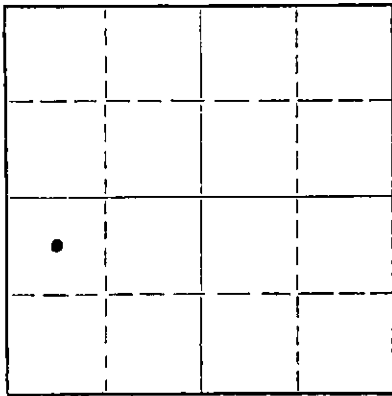

Locate well correctly on above  
Section Plat

Ness County, Sec. 21 Twp 19S Rge. (E) 25 (W)  
Location as "NE/CNW/SW" or footage from lines NW-SW  
Lease Owner Aspen Drilling Co.  
Lease Name Dinges Well No. 1  
Office Address P. O. Box 783, Great Bend, Kansas  
Character of Well (completed as Oil, Gas or Dry Hole) Dry Hole  
Date well completed November 1 19 69  
Application for plugging filed November 4 19 69  
Application for plugging approved 19  
Plugging commenced November 1 19 69  
Plugging completed same 19  
Reason for abandonment of well or producing formation Dry Hole

If a producing well is abandoned, date of last production 19  
Was permission obtained from the Conservation Division or its agents before plugging was commenced? yes

Name of Conservation Agent who supervised plugging of this well Leo Massey  
Producing formation Depth to top Bottom Total Depth of Well 4625 Feet  
Show depth and thickness of all water, oil and gas formations.

OIL, GAS OR WATER RECORDS

CASING RECORD

FORMATION	CONTENT	FROM	TO	SIZE	PUT IN	PULLED OUT

Describe in detail the manner in which the well was plugged, indicating where the mud fluid was placed and the method or methods used in introducing it into the hole. If cement or other plugs were used, state the character of same and depth placed, from feet to feet for each plug set.

Pushed plug to 720', 70 sacks cement;  
20 sacks cement at 375';  
bridge plug and 10 sacks cement at 40'.

RECEIVED  
STATE CORPORATION COMMISSION  
NOV 5 1969  
CONSERVATION DIVISION  
Wichita, Kansas

(If additional description is necessary, use BACK of this sheet)  
Name of Plugging Contractor Aspen Drilling Co.  
Address P. O. Box 783, Great Bend, Kansas

STATE OF Kansas COUNTY OF Barton, ss.  
William S. Schachle (employee of owner) or (owner or operator) of the above-described well, being first duly sworn on oath, says: That I have knowledge of the facts, statements, and matters herein contained and the log of the above-described well as filed and that the same are true and correct. So help me God.

(Signature) William S. Schachle  
William S. Schachle  
P. O. Box 783, Great Bend, Kansas  
(Address)

SUBSCRIBED AND SWORN TO before me this 4th day of November, 19 69

My commission expires April 18, 1972

Theora Holleman  
Theora Holleman Notary Public.

DRILLERS LOG

COMPANY: Aspen Drilling Co.  
 CONTRACTOR: Aspen Drilling Co.  
 LEASE NAME: Dinges #1  
 LOCATION: NW-SW Sec. 21-T19S-R25W  
 Ness County, Kansas  
 ELEVATION: 2583' KB  
 SURFACE CASING: 10 jts. (402') 8 5/8"  
 COMMENCED: October 20, 1969  
 COMPLETED: November 1, 1969  
 ROTARY TOTAL DEPTH: 4625'

<u>FORMATION</u>	<u>DEPTH</u>	
Shale	270	Ran 10 jts. (402') 8 5/8" casing set at
Sand	325	408' with 275 sacks. Cement circulated.
Shale	665	
Shale & Sand	760	DST #1 4607-4615
Shale	775	DST #2 4615-4625
Shale & Shells	980	
Anhydrite	1011	Ran electric log.
Shale & Shells	1859	
Anhydrite	1875	
Shale & Lime	2458	
Lime & Shale	3860	
Shale	3950	
Lime & Shale	4115	
Lime	4625	
RTD	4625	

RECEIVED  
 STATE CORPORATION COMMISSION  
 NOV 5 1969  
 CONSERVATION DIVISION  
 Wichita, Kansas

AFFIDAVIT

State of Kansas )  
 ) ss:  
 County of Barton )

The undersigned, being duly sworn on oath, states that the above statement and log are a true and correct record and log of the well drilled at the location above described.

William S. Schachle  
 William S. Schachle, Affiant

Subscribed and sworn to before me this 3rd day of November, 1969.

Theora Holleman  
 Theora Holleman, Notary Public

My commission expires: April 18, 1972.