


Give All Information Completely  
Make Required Affidavit  
Mail or Deliver Report to:  
Conservation Division  
State Corporation Commission  
211 No. Broadway  
Wichita, Kansas

WELL PLUGGING RECORD

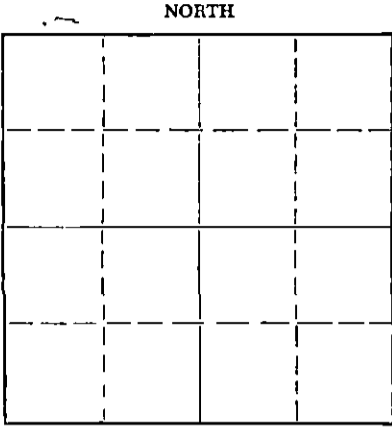

Locate well correctly on above  
Section Plat

Barton County. Sec. 18 Twp. 20S Rge. 13 (E) W(W)  
Location as "NE/CNW/SE/SW" or footage from lines SE NE NW  
Lease Owner Frontier Oil Company  
Lease Name Harrison Well No. 1  
Office Address 580 Fourth National Bank Building  
Character of Well (completed as Oil, Gas or Dry Hole) Dry Hole  
Date well completed November 10 1957  
Application for plugging filed November 10 1957  
Application for plugging approved November 10 1957  
Plugging commenced November 10 1957  
Plugging completed November 10 1957  
Reason for abandonment of well or producing formation \_\_\_\_\_

If a producing well is abandoned, date of last production \_\_\_\_\_ 19\_\_\_\_  
Was permission obtained from the Conservation Division or its agents before plugging was commenced? yes

Name of Conservation Agent who supervised plugging of this well Harold J. Hollis  
Producing formation \_\_\_\_\_ Depth to top \_\_\_\_\_ Bottom \_\_\_\_\_ Total Depth of Well \_\_\_\_\_ Feet  
Show depth and thickness of all water, oil and gas formations.

OIL, GAS OR WATER RECORDS

CASING RECORD

FORMATION	CONTENT	FROM	TO	SIZE	PUT IN	PULLED OUT
				8 5/8"	793*	

Describe in detail the manner in which the well was plugged, indicating where the mud fluid was placed and the method or methods used in introducing it into the hole. If cement or other plugs were used, state the character of same and depth placed, from \_\_\_\_\_ feet to \_\_\_\_\_ feet for each plug set.

Filled hole with heavy mud to 300\*  
Set bottom plug @ 300\*. Put 1/2 sack  
Hulls and 15 sacks of cement on bottom  
plug. Filled hole with heavy mud to  
40\*, set top plug @ 40\*, put 1/2 sack  
of Hulls and 10 sacks of Cement on top  
plug. Filled to bottom of cellar.

RECEIVED  
STATE CORPORATION COMMISSION

NOV 15 1957 11-13-1957

CONSERVATION DIVISION  
Wichita, Kansas

(If additional description is necessary, use BACK of this sheet)

Name of Plugging Contractor Red Tiger Drilling Company  
Address Box 173, Russell, Kansas.

STATE OF KANSAS, COUNTY OF SEDGWICK, ss.  
George A. Angle (employee of owner) or (owner or operator) of the above-described well, being first duly sworn on oath, says: That I have knowledge of the facts, statements, and matters herein contained and the log of the above-described well as filed and that the same are true and correct. So help me God.

(Signature) George A. Angle

580 Fourth National Bank Building, Wichita  
(Address)

SUBSCRIBED AND SWORN to before me this 12th day of November, 19 57

My commission expires 11-17-58

Notary Public.

PLUGGING  
FILE SEC 18 T. 20 R. 13W  
BOOK PAGE 61 LINE 1

DRILLERS LOG

No. 1 Harrison

CASING RECORD: 8 5/8" @ 793' w/475 sx cement.  
 COMPANY: Frontier Oil Company  
 CONTRACTOR: Red Tiger Drilling Company  
 COMMENCED: October 30, 1957  
 COMPLETED: November 10, 1957  
 DESCRIPTION: SE NE NW 18-20S-13W Barton County, Kansas  
 ELEVATION: 1880DF 1883 RB

TOTAL DEPTH: 3546 (-1663)

<u>FORMATION</u>	<u>FROM</u>	<u>TO</u>	<u>REMARKS</u>
Sod and Sand	0	200	
Shale and Shells	200	485	
Sand	485	500	
Sand-pyrites	500	615	
Red bed Shale and Shells	615	720	
Red Bed and Shells	720	789	
Anhydrite	789	816	
Shale and Shells	816	1125	
Shale and Shells	1125	1565	
Lime Shale	1565	3075	
Lime	3075	3200	
Shale and Lime	3200	3295	
Lime	3295	3322	
Shale and Lime	3322	3336	
Lime	3336	3512	
Lime and Shale	3512	3521	
Lime	3521	3541	
Arbuckle	3541	3546	

I certify that this is a true and correct copy of the above log to the best of my knowledge.

FRONTIER OIL COMPANY

George A. Angle  
 George A. Angle

Subscribed and sworn to before me this 12<sup>th</sup> day of November, 1957

Mapine Head  
 Notary Public

My Commission Expires:

11-17-58

PLUGGING  
 FILE SEC. 18. T. 20. R. 13W  
 BOOK PAGE 61. LINE 1