

STATE OF KANSAS
STATE CORPORATION COMMISSION

WELL PLUGGING RECORD

OR


FORMATION PLUGGING RECORD

Strike out upper line when reporting plugging off formations.

Give All Information Completely
Make Required Affidavit
Mail or Deliver Report to:
Conservation Division
State Corporation Commission
800 Bitting Building
Wichita, Kansas

Barton County. Sec. 18 Twp 20 Rge 13 (E) W (W)
Location as "NE $\frac{1}{4}$ NW $\frac{1}{4}$ SW $\frac{1}{4}$ " or footage from lines NW-NW-NW
Lease Owner J. Goldstein
Lease Name Harrison Well No. 1
Office Address 313 Boston Bldg. Denver, Colorado
Character of Well (completed as Oil, Gas or Dry Hole) Not commercial
Date well completed 10-12-1951 19
Application for plugging filed 12-16-1952 19
Application for plugging approved Same 19
Plugging commenced 12/17/1952 19
Plugging completed 12/31/1952 19
Reason for abandonment of well or producing formation Not paying

NORTH

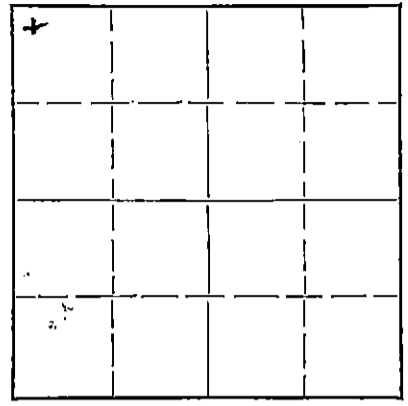

Locate well correctly on above Section Plat

If a producing well is abandoned, date of last production..... 19
Was permission obtained from the Conservation Division or its agents before plugging was commenced? Yes

Name of Conservation Agent who supervised plugging of this well C. D. Stough
Producing formation..... Depth to top..... Bottom..... Total Depth of Well 3552 Feet
Show depth and thickness of all water, oil and gas formations.

OIL, GAS OR WATER RECORDS

CASING RECORD

Formation	Content	From	To	Size	Put In	Pulled Out
				5 1/2	3552	3243
				8 / 58	1000	None

Describe in detail the manner in which the well was plugged, indicating where the mud fluid was placed and the method or methods used in introducing it into the hole. If cement or other plugs were used, state the character of same and depth placed, from..... feet to..... feet for each plug set.

3555 to 3525 ft. Sand bridge
3525 to 3495 5 Sks. cement
3495 to 300 Mudded
300 to 290 Rock bridge
290 to 240 20 Sks. cement
240 to 30 Mud
30 to Celler 10 Sks. cement

RECEIVED
STATE CORPORATION COMMISSION
JAN 7 - 1953
CONSERVATION DIVISION
Wichita, Kansas

(If additional description is necessary, use BACK of this sheet)

Correspondence regarding this well should be addressed to.....
Address.....

STATE OF Kansas, COUNTY OF Barton, ss.

A. R. Ash (employee of owner) or (owner or operator) of the above-described well, being first duly sworn on oath, says: That I have knowledge of the facts, statements, and matters herein contained and the log of the above-described well as filed and that the same are true and correct. So help me God.

(Signature) R. S. Pipe Pulling Co.
A. R. Ash (Address)

SUBSCRIBED AND SWORN to before me this 6 day of Jan, 1953
Phis. D. Hester Notary Public.

My commission expires Oct-28-1956

PLUGGING
FILE SEC 18 T 20 R 13
BOOK PAGE 66 LINE 10

WELL LOG BUREAU--KANSAS GEOLOGICAL SOCIETY

508 East Murdock,

Wichita, Kansas

15.009.00472.0000

Company- JOHN LINDAS OIL INC. ET AL
Farm- Harrison No. 1

SEC. 18 T. 20 R. 13W
NW NW NW

Total Depth. 3550
Comm. 9-29-51 Comp. 10-12-51
Shot or Treated.
Contractor.
Issued. 12-15-51

County Barton
KANSAS



54 CASING: 100
~~7-27-51~~ 3550' com. ~~W/400~~

Elevation. 1879 DE

Production. 125 BO

Figures Indicate Bottom of Formations.

soil & sand	132
shale & shells	225
shale & sand	300
shale	425
shale, sand & red bed	525
sand	540
red bed	580
red bed, shale & shells	791
anhydrite	820
red bed & shale	1065
shale & shells	1575
sand & lime	1705
sand & shale	1820
sand, lime & shale	1990
lime & shale	2280
shale & sand	2335
shale, lime & shells	2551
lime & shale	2875
lime	3220
shale & lime	3265
lime	3510
lime arbuckle	3550
Total Depth	

1879
220
1059

Scout Tops:	
Heebner	3131
Toronto	3147
Brown Lime	3237
Lansing	3248
Arbuckle	3502

PLUGGING
WELL SEC. 18 T. 20 R. 13W
BOOK PAGE 66 LINE 10

RECEIVED
REGISTRATION COMMISSION
JAN 7 - 1953
CONSERVATION DIVISION
Wichita, Kansas