


WELL PLUGGING RECORD

Give All Information Completely  
 Make Required Affidavit

COUNTY McPherson SEC. 31 TWP. 20 RGE. 3 E/W  
 Location as in quarters or footage from lines:  
NE SW NE

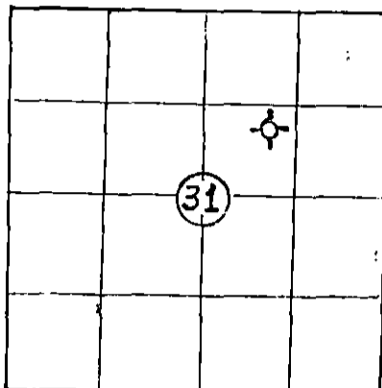

Locate Well  
 correctly on above  
 Section Platt.

Lease Owner R. J. Walker Oil Co., Inc.  
 Lease Name J. Schrag Well No. 1-31  
 Office Address 3524 N.W. 56th St. Okla. City, Okla. 73112  
 Character of Well (Completed as Oil, Gas or Dry Hole): Dry Hole  
 Date Well Completed 3-18-83  
 Application for plugging filed 3-18-83  
 Plugging commenced 3-18-83  
 Plugging completed 3-18-83  
 Reason for abandonment of well or producing formation  
D & A (C) (L)

Was permission obtained from the Conservation Division or it's  
 Agent's before plugging was commenced? Yes

Name of Conservation Agent who supervised plugging of this well Merlin Unruh  
 Producing formation none Depth to top \_\_\_\_\_ bottom \_\_\_\_\_ T.D. 3910'  
 Show depth and thickness of all water, oil and gas formations.

OIL, GAS OR WATER RECORDS

Casing Record

Formation	Content	From	To	Size	Put in	Pulled Out
				13 3/8"	227'	-0-
				8 5/8"	662'	-0-

Describe in detail the manner in which the well was plugged, indicating where the mud  
 fluid was placed and the method or methods used in introducing it into the hold. If cement  
 or other plugs were used, state the character of same and depth placed, from \_\_\_\_\_ feet  
 to \_\_\_\_\_ feet for each plug set.

40 sax Common @ 720' through drill pipe w/pump truck  
30 sax Common @ 275' through drill pipe w/pump truck  
1/2 sax hulls, plug, & 10 sax @ 40'  
10 sax in RH & 10 sax in MH  
Plugged @ 8:30 AM

(If additional description is necessary, use BACK of this sheet)

Name of Plugging Contractor Kansas Drilling & Well Service, Inc.

STATE OF Oklahoma COUNTY OF Oklahoma, ss.  
Oscar Goode (employee of owner) or (owner or operator) of the  
 above-described well, being first duly sworn on oath, says: That I have knowledge of the  
 facts, statements, and matters herein contained and the log of the above-described well as  
 filed and that the same are true and correct. So help me God.

(Signature) Oscar Goode  
3524 NW 56th St., #150 Okla City, Ok 73112  
 (Address)

SUBSCRIBED AND SWORN TO before me this 28th day of March, 19 83

RECEIVED  
 STATE CORPORATION COMMISSION

Notary Public.

My Commission expires: \_\_\_\_\_

MAR 31 1983

CONSERVATION DIVISION  
 Wichita, Kansas