


STATE OF KANSAS
STATE CORPORATION COMMISSION

WELL PLUGGING RECORD

Give All Information Completely
Make Required Affidavit
Mail or Deliver Report to:
Conservation Division
State Corporation Commission
800 Bittling Building
Wichita, Kansas

Pawnee County, Sec. 36 Twp. 20S Rge. (E) 16 (W)
Location as "NE/CNW/SW" or footage from lines NW NW SE
Lease Owner Brunson Production & Expl. Inc. & Tomlinson-Kathol, Inc.
Lease Name Dechert Well No. 1
Office Address 414 Union Center Bldg.
Character of Well (completed as Oil, Gas or Dry Hole) Dry Hole
Date well completed November 6 19 57
Application for plugging filed November 6 19 57
Application for plugging approved November 6 19 57
Plugging commenced November 6 19 57
Plugging completed November 6 19 57
Reason for abandonment of well or producing formation Dry Hole

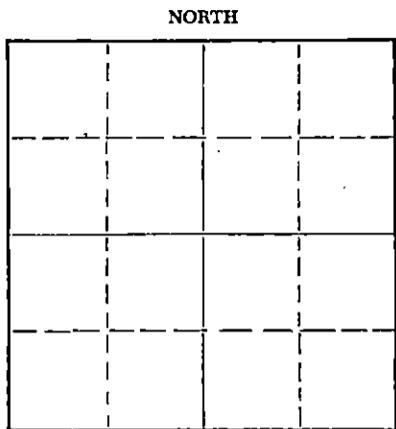

Locate well correctly on above Section Plat

If a producing well is abandoned, date of last production 19
Was permission obtained from the Conservation Division or its agents before plugging was commenced? Yes

Name of Conservation Agent who supervised plugging of this well Donald Truan
Producing formation Depth to top Bottom Total Depth of Well 3825 Feet
Show depth and thickness of all water, oil and gas formations.

OIL, GAS OR WATER RECORDS

CASING RECORD

FORMATION	CONTENT	FROM	TO	SIZE	PUT IN	PULLED OUT
				8-5/8	1019'	None

Describe in detail the manner in which the well was plugged, indicating where the mud fluid was placed and the method or methods used in introducing it into the hole. If cement or other plugs were used, state the character of same and depth placed, from feet to feet for each plug set.

Filled hole to 550' set plug - 25 sacks cement - filled hole to 250' set plug, 1/2 sack Hulls, 20 sacks cement, filled hole to 40' plug 1/2 sack Hulls, 10 sacks cement

RECEIVED
STATE CORPORATION COMMISSION
NOV 7 1957
11-13-57
DIVISION

(If additional description is necessary, use BACK of this sheet)
Name of Plugging Contractor Tomlinson-Kathol, Inc.
Address 414 Union Center, Wichita, Kansas

STATE OF Kansas, COUNTY OF Sedgwick, ss.
Warren E. Tomlinson (employee of owner) or (owner or operator) of the above-described well, being first duly sworn on oath, says: That I have knowledge of the facts, statements, and matters herein contained and the log of the above-described well as filed and that the same are true and correct. So help me God.

(Signature) Warren E Tomlinson
414 Union Center Bldg.
(Address)

SUBSCRIBED AND SWORN TO before me this 11th day of November, 19 57

Esther Lamore
Notary Public.

My commission expires Jan. 19, 1961

PLUGGING
FILE SEC 36 T. 20. R. 16W
BOOK PAGE 60 LINE 45

DRILLERS LOG

15.145.00278.0000

1-DECKERT

NW NW SE, SEC. 36-20S-16W

Pawnee County, Kansas

Operator - Brunson Production & Exploration, Inc.
and Tomlinson-Kathol, Inc.

Commenced - 10/25/57

Contractor - Tomlinson-Kathol, Inc.

Completed - 11/6/57

Elevation 2007 KB

Dry & Abandoned

<u>From</u>	<u>To</u>	<u>Description</u>	<u>Remarks</u>
0	200	Clay & shale	
200	275	Sand	
275	430	Shale	
430	560	Sand	
560	670	Shale & sand streaks	
670	900	Shale & clay	
900	1015	Shale & sand	
1015	1041	Anhydrite	8-5/8" Casing set @ 1019' with 225 sks cement 2% get 1% CC 200 sks cement with 2% CC
1041	1810	Shale & shells	
1810	1850	Shale & lime	
1850	1882	Lime	
1882	3144	Lime & shale	
3144	3242	Lime	
3242	3447	Lime & shale	
3447	3472	Lime	
3472	3555	Lime & shale	
3555	3560	Cherty lime	
3560	3602	Lime & shale	
3602	3674	Lime	
3674	3714	Lime & shale	
3714	3740	Cherty lime	
3740	3780	Cherty lime & shale	
3780	3825	Arbuckle lime	
3825		Total Depth of Hole	Schlumberger

PLUGGING
 FILE SEC 36 T 20 R 16W
 BOOK PAGE 60 LINE 45

I certify that to the best of my knowledge and belief, the above represents a true and accurate Driller's Log record of the captioned well.

STATE OF KANSAS
 COUNTY OF SEDGWICK
 RECEIVED
 STATE CORPORATION COMMISSION
 NOV 13 1957
 CONSERVATION DIVISION
 Wichita, Kansas

Warren E. Tomlinson
 Warren E. Tomlinson

Subscribed and sworn to before me this 11th day of November, 1957.

Esther Lamone
 Notary Public

My commission expires Jan. 19, 1961.