

STATE OF KANSAS  
STATE CORPORATION COMMISSION


Form CP-4

Give All Information Completely  
Make Required Affidavit  
Mail or Deliver Report to  
Conservation Division  
State Corporation Commission

WELL PLUGGING RECORD

P. O. Box 17027  
Wichita, Kansas 67217  
North

McPherson County, Sec. 15, Twp. 20S, Rge. 3, XXX (W)  
Location as "NE/CNW/SE/SW" or footage from lines NE NW NE  
Lease Owner Barnett Oil, Inc.  
Lease Name Stuckey Well No. 7  
Office Address 16th Floor KSB&T Bldg. - Wichita, Ks. 67202  
Character of Well (completed as Oil, Gas or Dry Hole) dry hole  
Date well completed October 7, 19 75  
Application for plugging filed October 7, 19 75  
Application for plugging approved October 7, 19 75  
Plugging commenced October 7, 19 75  
Plugging completed October 7, 19 75  
Reason for abandonment of well or producing formation D&A

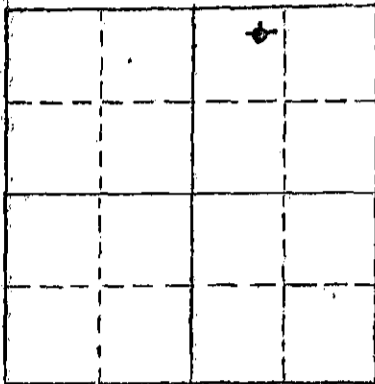

Locate well correctly on above  
Section Plot

If a producing well is abandoned, date of last production 19  
Was permission obtained from the Conservation Division or its agents before plugging was commenced? yes

Name of Conservation Agent who supervised plugging of this well Hugh F. Scott  
Producing formation \_\_\_\_\_ Depth to top \_\_\_\_\_ Bottom \_\_\_\_\_ Total Depth of Well 3060 Feet  
Show depth and thickness of all water, oil and gas formations.

OIL, GAS OR WATER RECORDS

CASING RECORD

FORMATION	CONTENT	FROM	TO	SIZE	PUT IN	PULLED OUT
				8 5/8"	240'	-0-

Describe in detail the manner in which the well was plugged, indicating where the mud fluid was placed and the method or methods used in introducing it into the hole. If cement or other plugs were used, state the character of same and depth placed, from \_\_\_\_\_ feet to \_\_\_\_\_ feet for each plug set.

Mud to 270' - 38 sacks cement - Mud to 40', 1/4 sack hulls - Plug w/10 sacks  
2 sacks in rathole

RECEIVED  
STATE CORPORATION COMMISSION

OCT 21 1975

CONSERVATION DIVISION  
WICHITA, KANSAS

10-21-75

(If additional description is necessary, use BACK of this sheet)  
Name of Plugging Contractor Red Tiger Drilling Company  
Address 1720 Wichita Plaza, Wichita, Ks. 67202

STATE OF Kansas, COUNTY OF Sedgwick ss.  
Jean Stocks (employee of owner) or ~~known to me~~ of the above-described

well, being first duly sworn on oath, says: That I have knowledge of the facts, statements, and matters herein contained and the log of the above-described well as filed and that the same are true and correct. So help me God.

(Signature) Jean Stocks  
1720 Wichita Plaza, Wichita, Ks. 67202  
(Address)



Subscribed and sworn to before me this 15th day of October, 19 75

(Signature) D'Ann Drennan  
Notary Public.

My commission expires \_\_\_\_\_

DRILLERS LOG

15.113.20301.0000

No. 1 Stuckey

CASING RECORD:

8 5/8" @240'  
w/175 sx cmt

COMPANY:

Barnett Oil, Inc.

DESCRIPTION:

NE NW NE  
15-20S-3W  
McPherson County,  
Kansas

CONTRACTOR:

Red Tiger Drilling Company

COMMENCED:

October 1, 1975

COMPLETED:

October 7, 1975

TOTAL DEPTH: 3060'

ELEVATION: 1498' K.B.

FORMATION

FROM

TO

REMARKS

Sand	0	130
Shale & Clay	130	244
Shale & Lime	244	1880
Lime	1880	2027
Shale & Lime	2027	2435
Lime	2435	2565
Shale & Lime	2565	2785
Lime	2785	3051
Miss.	3051	3060

RECEIVED  
STATE CORPORATION COMMISSION

OCT 21 1975

CONSERVATION DIVISION  
Wichita, Kansas


I certify that this is a true and correct copy of the above log to the best of my knowledge.

RED TIGER DRILLING COMPANY

  
Jean Stocks

Subscribed and sworn to before me this 15th day of October, 1975.

My Commission Expires:

  
Notary Public

