

STATE OF KANSAS
STATE CORPORATION COMMISSION

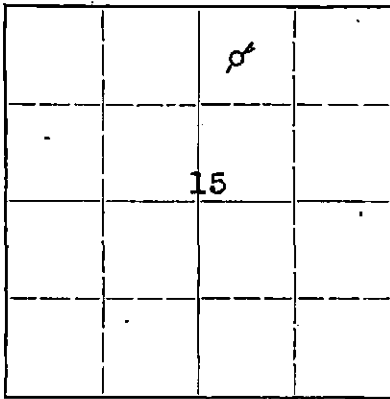
WELL PLUGGING RECORD

OR

FORMATION PLUGGING RECORD

Strike out upper line
when reporting plug-
ging off formations.Give All Information Completely
Make Required Affidavit:
Mail or Deliver Report to:
Conservation Division
State Corporation Commission
800-Bitting Building
Wichita, Kansas

NORTH

Locate well correctly on above
Section Plat

McPherson County. Sec. 15 Twp. 20 Rge. 3W (S) (W)
Location as "NE $\frac{1}{4}$ NW $\frac{1}{4}$ SW $\frac{1}{4}$ " or footage from lines Center of NW of NE $\frac{1}{4}$
Lease Owner. The Lotus Oil Co.
Lease Name. Sinden Well No. 1
Office Address. 900 Land Bank Bldg., Kansas City, Mo.
Character of Well (completed as Oil, Gas or Dry Hole) Dry
Date well completed. May 2, 1948
Application for plugging filed 1948
Application for plugging approved. June 3, 1948
Plugging commenced. May 19 1948
Plugging completed. May 26 1948
Reason for abandonment of well or producing formation. Water

If a producing well is abandoned, date of last production 1948
Was permission obtained from the Conservation Division or its agents before plugging was commenced? Yes
Mr. Petty

Name of Conservation Agent who supervised plugging of this well.
Producing formation. Miss. Ls. Depth to top. 3026' Bottom. -- Total Depth of Well. 3095' Feet
Show depth and thickness of all water, oil and gas formations.

OIL, GAS OR WATER RECORDS

CASING RECORD

Formation	Content	From	To	Size	Put In	Pulled Out
Miss. Ls.	Water	3054'	3095'	5 $\frac{1}{2}$ "	3028'	2721'

Describe in detail the manner in which the well was plugged, indicating where the mud fluid was placed and the method or methods used in introducing it into the hole. If cement or other plugs were used, state the character of same and depth placed, from feet to feet for each plug set.

Dumped 6 sacks of cement in bottom of hole. Shot pipe off at 2721'. Circulated pipe with Halliburton. Pulled pipe out and mudded hole to 200'. Dumped 15 sacks of cement at 200'. Finished mudding hole to 10' of the top. Put 8 sacks of cement in top of surface pipe.

6-10-48

JUN 10 1948

(If additional description is necessary, use BACK of this sheet)

Correspondence regarding this well should be addressed to The Lotus Oil Company
Address. 900 Land Bank Building, Kansas City, Missouri

STATE OF Missouri, COUNTY OF Jackson, ss.
Albert R. Jones (employee of owner) or (owner or operator) of the above-described well,
being first duly sworn on oath, says: That I have knowledge of the facts, statements, and matters herein contained and the log of the above-described well as filed and that the same are true and correct. So help me God.

(Signature)

Albert R. Jones
President of The Lotus Oil Company
900 Land Bank Bldg., Kansas City, Mo.
(Address)

SUBSCRIBED AND SWORN to before me this 9th day of June, 1948

My commission expires December 15, 1948

Marguerite R. McQuinn
Notary Public.

PLUGGING
FILE SEC 15 T 20 R 3W
BOOK PAGE 33 LINE 22

27-6858-RS

2-17-GM

COMPANY: LOTUS OIL COMPANY
 CONTRACTOR: & HALLARD DRILLING COMPANY
 TARN: Sinden #1
 LOCATION: NW C NE/4
 Sec. 15-20-3W, Mc Pherson County, Kansas
 COMMENCED: April 14, 1948
 COMPLETED: April 23, 1948 --Rotary
 May 2, 1948 --Cardwell

0	to	158	Surface sand
158	to	435	Shale and shells
435	to	460	Anhydrite
460	to	495	Shale-lime and shells
495	to	695	Shale-lime and sand
695	to	870	Sand and lime
870	to	1020	Lime, shale and sand
1020	to	2455	Lime and shale
2455	to	2640	Lime
2640	to	2980	Lime and shale
2980	to	3026	Shale and lime
3026	to	3034 $\frac{1}{2}$	Chat--T.D. Potary
3034 $\frac{1}{2}$	to	3050	Chat, show gas
3050	to	3055	Chat, water
3055	to	3093	Chat, water
		3093	T.D.--Cardwell

Set 158 feet of 8 5/8" surface pipe. Cemented with 110 sacks.

Set pipe at 3027--5 1/2". Cemented with 45 sacks cement.

TOPS: Chat--3026

Measurements taken from top of derrick floor

DRY, ABANDONED AND PLUGGED

C E R T I F I C A T E

I, C. C. Nelson, do hereby certify that the above and foregoing is a true and correct copy of the log of Sinden #1, Sec. 15-20-3W, Mc Pherson County, Kansas, as reflected by files of the Hallard Drilling Company.

Subscribed and sworn to before me a Notary Public, within and for Sedgwick County, Kansas, this _____ day of May 1948.

My commission expires _____

JUN 10 1948

15-20-3W
 33-22