


WELL PLUGGING RECORD

Give All Information Completely
Make Required Affidavit
Mail or Deliver Report to:
Conservation Division
State Corporation Commission
212 North Market, Insurance Bldg.
Wichita, Kansas

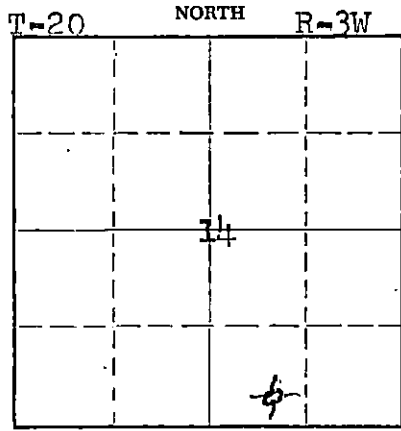

Locate well correctly on above Section Plat

McPherson County. Sec. 14 Twp. 20 Rge. (E) 3 (W)
Location as "NE/CNW/SW" or footage from lines C SE SW SE
Lease Owner Donald T. Ingling et al
Lease Name Juhnke Well No. 1
Office Address 623 1st Nat'l Bank Bldg., Wichita 2, Kans.
Character of Well (completed as Oil, Gas or Dry Hole) Dry Hole
Date well completed January 6, 1960
Application for plugging filed January 6, 1960
Application for plugging approved January 6, 1960
Plugging commenced January 6, 1960
Plugging completed January 6, 1960
Reason for abandonment of well or producing formation dry

If a producing well is abandoned, date of last production 19
Was permission obtained from the Conservation Division or its agents before plugging was commenced? Yes - well log attached herewith

Name of Conservation Agent who supervised plugging of this well Cecil M. Jones
Producing formation _____ Depth to top _____ Bottom _____ Total Depth of Well 3123 Feet
Show depth and thickness of all water, oil and gas formations.

OIL, GAS OR WATER RECORDS

CASING RECORD

FORMATION	CONTENT	FROM	TO	SIZE	PUT IN	PULLED OUT
				8 5/8"	162'	None

Describe in detail the manner in which the well was plugged, indicating where the mud fluid was placed and the method or methods used in introducing it into the hole. If cement or other plugs were used, state the character of same and depth placed, from _____ feet to _____ feet for each plug set.

Laid down drill pipe, plugged hole, put bridge at 180 feet, then 15 sacks cement - filled hole with mud to 35 feet, then top plug and 8 sacks cement and 2 sacks of cement in rathole.

RECEIVED
STATE CORPORATION COMMISSION

JAN 8 1960

CONSERVATION DIVISION
Wichita, Kansas

(If additional description is necessary, use BACK of this sheet)

Name of Plugging Contractor Donald T. Ingling
Address 623 1st Nat'l Bank Bldg., Wichita 2, Kansas

STATE OF KANSAS, COUNTY OF SEDGWICK, ss.
D. T. Ingling (employee of owner) or (owner or operator) of the above-described well, being first duly sworn on oath, says: That I have knowledge of the facts, statements, and matters herein contained and the log of the above-described well as filed and that the same are true and correct. So help me God.

(Signature) *D. T. Ingling*
623 1st Nat'l Bank Bldg., Wichita 2
(Address)

SUBSCRIBED AND SWORN to before me this 7th day of January, 1960

My commission expires Feb. 27, 1960 *M. E. Black* Notary Public.



WELL LOG - JUHNKE NO. 1

Donald T. Ingling et al, Lease Owner
 Donald T. Ingling, Contractor
 Commenced: December 26, 1959
 Completed: January 6, 1960.
 Total Depth: 3123'
 Casings: 8 5/8" 162' (80 sacks cement)

Section 14-20-3W
 Location: C SE SW SE
 County: McPherson
 Production: dry
 Elevation: 1497 RB

B

Figures below indicate bottom formation

80 sand and shale	3045 shale
162 shale and shells	3076 shale
330 shale	3091 lime - Mississippi
485 shale and lime streaks	3099 Mississippi
765 lime	3123 Mississippi
930 lime	3123 Total Depth
1185 shale	
1470 shale and shells	
1490 lime	
1535 shale and shells	
1750 shale and shells	
1870 shale and lime	
2015 lime	
2100 lime	
2160 lime	
2185 shale	
2343 shale and sand	
2348 lime - Brown	
2360 shale	
2403 shale	
2445 lime	
2495 lime	
2620 lime	
2675 lime	
2715 lime	
2765 lime	
2800 shale	
2873 lime	
2945 shale	

RECEIVED
 STATE CORPORATION COMMISSION
 JAN 8 1960
 CONSERVATION DIVISION
 WICHITA, KANSAS

I certify this is a true and correct copy of the above mentioned well.

STATE OF KANSAS)
) ss.
 SEDGWICK COUNTY)

Donald T. Ingling

Subscribed and sworn to before me, a Notary Public, in said county and state.

M.E. Beach
 Notary Public

My commission expires: Feb. 27, 1960