


WELL PLUGGING RECORD

Give All Information Completely  
Make Required Affidavit  
Mail or Deliver Report to:  
Conservation Division  
State Corporation Commission  
800 Bitting Building  
Wichita, Kansas

Rice County, Sec. 3 Twp. 20 Rge. 6 (E) W(W)

Location as "NE/CNWSW" or footage from lines SE SE SE  
Lease Owner Beardmore Drilling Company  
Lease Name Lindell Well No. 1  
Office Address 827 Beacon Building, Wichita, Kansas  
Character of Well (completed as Oil, Gas or Dry Hole) \_\_\_\_\_  
Date well completed 10-3 1956  
Application for plugging filed 10-3 1956  
Application for plugging approved 10-3 1956  
Plugging commenced 10-3 1956  
Plugging completed 10-3 1956  
Reason for abandonment of well or producing formation Dry Hole

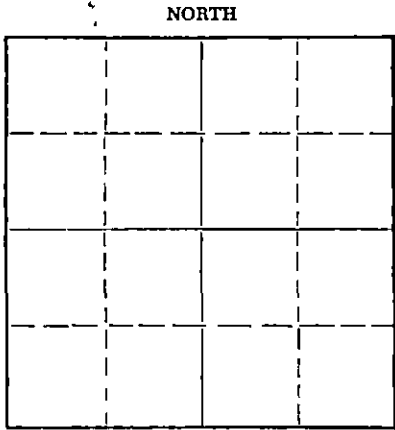

Locate well correctly on above Section Plat

If a producing well is abandoned, date of last production \_\_\_\_\_ 19\_\_\_\_  
Was permission obtained from the Conservation Division or its agents before plugging was commenced? Yes

Name of Conservation Agent who supervised plugging of this well Ruel Durkee  
Producing formation \_\_\_\_\_ Depth to top \_\_\_\_\_ Bottom \_\_\_\_\_ Total Depth of Well 3588 Feet  
Show depth and thickness of all water, oil and gas formations.

OIL, GAS OR WATER RECORDS

CASING RECORD

FORMATION	CONTENT	FROM	TO	SIZE	PUT IN	PULLED OUT
		0'	158'	8-5/8"	158'	0'

Describe in detail the manner in which the well was plugged, indicating where the mud fluid was placed and the method or methods used in introducing it into the hole. If cement or other plugs were used, state the character of same and depth placed, from \_\_\_\_\_ feet to \_\_\_\_\_ feet for each plug set.

- 0' to 35' - 5 sacks cement
- 35' - Wood Plug
- 35' to 105' - Heavy Mud
- 105' to 150' - 15 sacks cement
- 150' - Wood Plug
- 150' to 3588' - Heavt Mud

(If additional description is necessary, use BACK of this sheet)

Name of Plugging Contractor Beardmore Drilling Company  
Address 827 Beacon Building, Wichita, Kansas

STATE OF KANSAS, COUNTY OF SEDGWICK, ss.  
Heber Beardmore (employee of owner) or (owner or operator) of the above-described well, being first duly sworn on oath, says: That I have knowledge of the facts, statements, and log of the above-described well as filed and that the same are true and correct. So help me God.

(Signature) Heber Beardmore  
827 Beacon Building  
(Address)

SUBSCRIBED AND SWORN to before me this 9th day of October, 1956

My commission expires January 28, 1960

Leonard P. Tolle  
Leonard P. Tolle - Notary Public.

PLUGGING  
FILE SEC 3 T 20 R 6 W  
BOOK PAGE 105 LINE 28

RECEIVED  
OCT 16 1956  
CONSERVATION DIVISION  
Wichita, Kansas  
10-16-1956

BEARDMORE-EDMUND  
 #1 Lindell  
 SE SE SE Section 3-20S-6W  
 Rice County, Kansas

Drilled By: Beardmore Drilling Company  
 Drilling Commenced: 9-24-56  
 Drilling Completed: 10-3-56

Casing: 158' of 8-5/8" set at 156' with 120 sacks cement.  
 Cement circulated. 9-24-56.

Elevation: KB 1544  
 DF 1542  
 Gr 1539

<u>FORMATIONS</u>	<u>DEPTH</u>
Cellar	5
Sand and Shale	60
Shale and Shells	156
Shale	820
Lime	860
Shale and Lime	1065
Shale and Lime	1730
Shale and Lime	2300
Shale and Lime	2770
Sand	2840
Shale and Lime	2880
Lime	3095
Shale and Lime	3165
Chat and Lime	3240
Lime	3266
Shale and Lime	3305
Shale and Lime	3547
Sand	3588
Rotary Total Depth	3588
D & A	

TOPS

Mississippi	3225
Kinderhook	3270
Simpson Sand	3562

CORE #1 3547 to 3557 - Full recovery - no shows.

CORE #2 3557 to 3569 - Full recovery - no shows.

STATE OF KANSAS }  
 COUNTY OF SEDGWICK } SS

I, the undersigned, being duly sworn on oath state that the above and within statement is a true and correct record and log of the well drilled on the location above-described, to the best of my knowledge and belief.

*Robert J. Gutru*  
 \_\_\_\_\_  
 Robert J. Gutru

Subscribed and sworn to before me this 10th day of October, 1956.

*Leonard P. Tolle*  
 \_\_\_\_\_  
 Leonard P. Tolle-Notary Public

My Commission Expires:  
 January 28, 1960

PLUGGING			
FILE	SEC 3	T 20	R 6W
BOOK	PAGE 105	LINE	28

10-10-56  
 NOTARY PUBLIC  
 LEONARD P. TOLLE