


Give All Information Completely  
Make Required Affidavit  
Mail or Deliver Report to:  
Conservation Division  
State Corporation Commission  
300 Bittling Building  
Wichita, Kansas

WELL PLUGGING RECORD

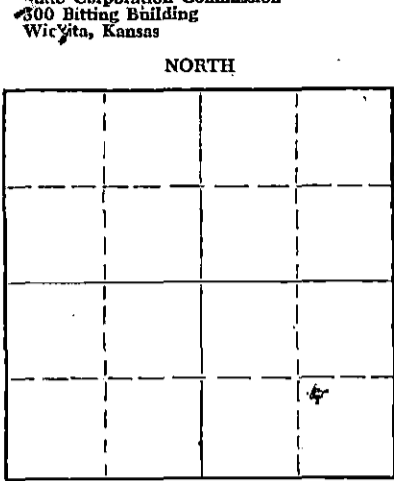

Locate well correctly on above Section Plat

McPherson County. Sec. 23 Twp. 20 Rge. 3 ~~20X~~ (W)  
Location as "NE/CNW/SW" or footage from lines NW SE SE/4  
Lease Owner E. K. Carey Drilling Co., Inc.  
Lease Name Joe D. C. Goering Well No. 1  
Office Address Box 620, McPherson, Kansas  
Character of Well (completed as Oil, Gas or Dry Hole) Dry hole  
Date well completed April 5, 1955 19  
Application for plugging filed April 5, " 19  
Application for plugging approved April 5, " 19  
Plugging commenced 1 PM April 5, " 19  
Plugging completed 3:30 PM April 5, " 19  
Reason for abandonment of well or producing formation Dry

If a producing well is abandoned, date of last production 19  
Was permission obtained from the Conservation Division or its agents before plugging was commenced? Yes

Name of Conservation Agent who supervised plugging of this well Ruel Durkee, McPherson, Kansas  
Producing formation \_\_\_\_\_ Depth to top \_\_\_\_\_ Bottom \_\_\_\_\_ Total Depth of Well 3123 Feet  
Show depth and thickness of all water, oil and gas formations.

| OIL, GAS OR WATER RECORDS |         |      |    | CASING RECORD |        |            |
|---------------------------|---------|------|----|---------------|--------|------------|
| FORMATION                 | CONTENT | FROM | TO | SIZE          | PUT IN | PULLED OUT |
|                           |         |      |    | 8-5/8         | 207    | None       |
|                           |         |      |    |               |        |            |
|                           |         |      |    |               |        |            |
Describe in detail the manner in which the well was plugged, indicating where the mud fluid was placed and the method or methods used in introducing it into the hole. If cement or other plugs were used, state the character of same and depth placed, from 207-162 feet to 25-15 feet for each plug set.

Gunned pits, circulated heavy mud on bottom, again half way out.  
Layed down all but 8 joints drill pipe, ran measuring line and filled with heavy mud to 207 feet. Made bridge with tree limb and rocks and 1/2 sack hulls to hold weight of 8 joints drill pipe. Layed down 2 joints drill pipe and mixed 15 sacks cement and put thru 6 joints of of drill pipe. Layed down rest of drill pipe and filled hole with heavy mud to 25 feet placed bridge there. Mixed 5 sacks cement and put on that bridge and filled to bottom of cellar floor. Through @ 3:30 PM

(If additional description is necessary, use BACK of this sheet)  
Name of Plugging Contractor E. K. Carey Contractor  
Address Box 620, McPherson, Kansas

STATE OF Kansas, COUNTY OF McPherson, ss.  
Arland Bruce, Tool Pusher (employee of owner) or (owner or operator) of the above-described well, being first duly sworn on oath, says: That I have knowledge of the facts, statements, and matters herein contained and the log of the above-described well as filed and that the same are true and correct. So help me God.

(Signature) Arland Bruce

(Address) \_\_\_\_\_

SUBSCRIBED AND SWORN TO before me this 6th day of April, 1955

My commission expires November 13, 1956

Notary Public.

**PLUGGING**  
FILE SEC 23 T20 R 20  
BOOK PAGE 109 LINE 43

RECEIVED  
STATE CORPORATION COMMISSION  
APR - 7 1955  
WICHITA, KANSAS

ROTARY DRILLER'S LOG

15.113.00135.0000

E. K. Carey Drilling Co., Inc.  
Box 620  
McPherson, Kansas

Elevations: 1484 K.B.  
1481 D.F.  
1478 Gr.

Joe D. C. Goering #1

NW SE SE/4  
Sec. 23-20-3W  
McPherson County, Kansas

Casing Record:  
8-5/8" @ 207' w/110 sks  
Reg. bulk cement and 100# cc.

Well Commenced: 3-21-55  
Well Completed: 4-5-55 D & A

Contractor: E. K. Carey Contractor, Rig #2, Box 620, McPherson, Kansas  
Geologist: Don Hollar, E. K. Carey Drlg. Co. 815 Central Bldg. Wichita

Figures Indicate Bottom of Formation K. B.

|                  |         |
|------------------|---------|
| Base and cellar  | 8       |
| Shale            | 45      |
| Sand             | 72      |
| Shale            | 192     |
| Shale and shells | 204     |
| Lime and shells  | 207     |
| Lime and shale   | 245     |
| Shale and lime   | 405     |
| Lime Andydrite   | 435     |
| Lime and shale   | 770     |
| Shale and lime   | 990     |
| Shale and shells | 1525    |
| Shale and lime   | 1825    |
| Lime and shale   | 1915    |
| Lime             | 2225    |
| Shale            | 2345    |
| Lime and shale   | 2400    |
| Lime             | 2560    |
| Lime and shale   | 2720    |
| Shale and lime   | 2833    |
| Lime and shale   | 2918    |
| Shale and lime   | 3025    |
| Shale and shells | 3075    |
| Lime             | 3123 TD |

Geologist Tops:

|                    |              |
|--------------------|--------------|
| Lansing            | 2404 (- 920) |
| Miss.              | 3074 (-1589) |
| Rotary Total Depth | 3123         |

This is to certify that the above information is to the best of my knowledge true and correct.

SUBSCRIBED AND SWORN to before me this 6th day of April, 1955

RECEIVED  
STATE GEOLOGICAL COMMISSION  
APR 11 1955  
CONSERVATION DIVISION  
Wichita, Kansas

E. K. CAREY CONTRACTOR

BY Herbert Rhoton  
Herbert Rhoton, Superintendent

Don Hollar

NP

My Commission Expires: November 13, 1956

PLUGGING  
FILE SEC 23 20 R 3W  
BOOK PAGE 109 LINE 43