


Give All Information Completely
Make Required Affidavit
Mail or Deliver Report to:
Conservation Division
State Corporation Commission
212 North Market, Insurance Bldg.
Wichita, Kansas

WELL PLUGGING RECORD

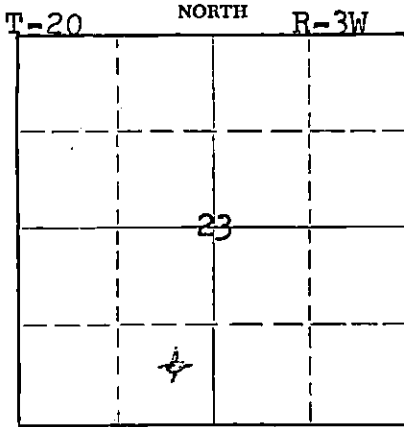

Locate well correctly on above Section Plat

McPherson County. Sec. 23 Twp. 20 Rge. (E) 3 (W)
Location as "NE/CNW/SW" or footage from lines. S/2 N/2 SE SW 1/4
Lease Owner Rains & Williamson Oil Co.
Lease Name F. Krehbiel Well No. 1
Office Address Union Center Building, Wichita 2, Kansas
Character of Well (completed as Oil, Gas or Dry Hole) Dry Hole
Date well completed February 4, 1960
Application for plugging filed February 4, 1960
Application for plugging approved February 4, 1960
Plugging commenced February 4, 1960
Plugging completed February 4, 1960
Reason for abandonment of well or producing formation dry

If a producing well is abandoned, date of last production _____ 19____
Was permission obtained from the Conservation Division or its agents before plugging was commenced? Yes

Name of Conservation Agent who supervised plugging of this well Cecil Jones
Producing formation _____ Depth to top _____ Bottom _____ Total Depth of Well 3125 Feet
Show depth and thickness of all water, oil and gas formations.

OIL, GAS OR WATER RECORDS				CASING RECORD		
FORMATION	CONTENT	FROM	TO	SIZE	PUT IN	PULLED OUT
				8 5/8"	206'	None

Describe in detail the manner in which the well was plugged, indicating where the mud fluid was placed and the method or methods used in introducing it into the hole. If cement or other plugs were used, state the character of same and depth placed, from _____ feet to _____ feet for each plug set.

Started laying down drill pipe, set plug at 180 feet, then one-half sack hulls and 15 sacks cement, mudded to 35 feet then one-half hulls and plug, then 8 sacks cement and 2 sacks cement in rat-hole.

RECEIVED
STATE CORPORATION COMMISSION
FEB 12 1960
CONSERVATION DIVISION
Wichita, Kansas

(If additional description is necessary, use BACK of this sheet)
Name of Plugging Contractor Donald T. Ingling
Address 623 1st Nat'l Bank Bldg., Wichita 2, Kansas

STATE OF KANSAS, COUNTY OF SEDGWICK, ss.
D. T. Ingling (employee of owner) or (owner or operator) of the above-described well, being first duly sworn on oath, says: That I have knowledge of the facts, statements, and matters herein contained and the log of the above-described well as filed and that the same are true and correct. So help me God.

(Signature) [Signature]
623 1st Nat'l Bank Bldg., Wichita 2
(Address)

SUBSCRIBED AND SWORN TO before me this 8th day of February 1960
[Signature]
Notary Public.

My commission expires Feb. 27, 1960

Rains & Williamson Oil Co., Lease Owner

Section 23-20-3W

Donald T. Ingling, Contractor

Location: 500' WEL, 165' SNL,
165' NSL, S/2 N/2
SE SW

Commenced: 1-27-60

Completed: 2-4-60

County: McPherson

Total Depth: 3125'

Production: Dry

Casing: 8 5/8" 206' (100 sacks cement)

Elevation: 1491 RB

Formation below indicates bottom formation

40	surface clay	3100	shale
110	sand	3115	Mississippi
205	shale and shells	3125	Mississippi
435	shale and shells	3125	Total Depth
715	lime		
915	lime		
940	lime		
1145	shale		
1475	shale and shells		
1490	lime		
1690	shale and shells		
1745	shale		
1880	lime and shale		
2020	lime		
2115	lime		
2150	lime		
2190	shale		
2230	sandy shale		
2342	sand and shale		
2345	lime - Brown		
2403	shale		
2415	lime - Lansing		
2490	lime		
2586	lime		
2655	lime		
2715	lime		
2760	shale		
2782	lime		
2785	shale		
3010	shale		
3080	shale		

RECEIVED
STATE CORPORATION COMMISSION
FEB 12 1960
CONSERVATION DIVISION
WICHITA, KANSAS

I certify this is a true and correct copy of the above mentioned well.

STATE OF KANSAS)
) SS.
SEDGWICK COUNTY)

Donald T. Ingling

Subscribed and sworn to before me, a Notary Public, in said county and state.

M. E. Beach
Notary Public

My commission expires: Feb. 27, 1960