


Give All Information Completely  
Make Required Affidavit  
Mail or Deliver Report to:  
Conservation Division  
State Corporation Commission  
212 North Market, Insurance Bldg.  
Wichita, Kansas

WELL PLUGGING RECORD

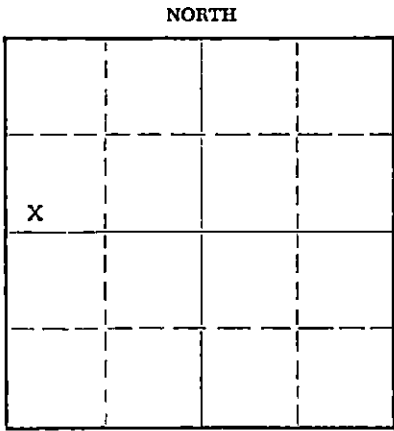

Locate well correctly on above Section Plat

McPherson County, Sec. 23 Twp. 20 Rge. ~~(E)~~ 3 (W)  
Location as "NE/CNW/SW" or footage from lines SW SW NW  
Lease Owner Donald T. Ingling  
Lease Name Schrag Well No. 1-a  
Office Address 623 First National Bldg., Wichita  
Character of Well (completed as Oil, Gas or Dry Hole)  
Date well completed May 13, 19 59  
Application for plugging filed April 12, 19 61  
Application for plugging approved April 13, 19 61  
Plugging commenced April 17, 19 61  
Plugging completed April 20, 19 61  
Reason for abandonment of well or producing formation low production

If a producing well is abandoned, date of last production 19  
Was permission obtained from the Conservation Division or its agents before plugging was commenced? Yes

Name of Conservation Agent who supervised plugging of this well Cecil Jones  
Producing formation \_\_\_\_\_ Depth to top \_\_\_\_\_ Bottom \_\_\_\_\_ Total Depth of Well 3107 Feet  
Show depth and thickness of all water, oil and gas formations.

OIL, GAS OR WATER RECORDS

CASING RECORD

FORMATION	CONTENT	FROM	TO	SIZE	PUT IN	PULLED OUT
				8 5/8	200'	none
				4 1/2	3078	2851.83

Describe in detail the manner in which the well was plugged, indicating where the mud fluid was placed and the method or methods used in introducing it into the hole. If cement or other plugs were used, state the character of same and depth placed, from \_\_\_\_\_ feet to \_\_\_\_\_ feet for each plug set.

Hole filled with chat to 3070 and 5 sacks cement dumped on chat.  
Set rock bridge at 190 ft. and dumped 20 sacks cement.  
Hole filled with mud to 30 ft. Set 5' rock bridge 25-30' and dumped 8 sacks cement on bridge.

RECEIVED  
STATE CORPORATION COMMISSION

APR 25 1961

CONSERVATION DIVISION  
Wichita, Kansas

(If additional description is necessary, use BACK of this sheet)  
Name of Plugging Contractor Kent Well Servicing Co., Inc.  
Address Box 470, El Dorado, Kansas

STATE OF Kansas, COUNTY OF Butler, ss.  
\_\_\_\_\_  
(employee of owner) or (owner or operator) of the above-described well, being first duly sworn on oath, says: That I have knowledge of the facts, statements, and matters herein contained and the log of the above-described well as filed and that the same are true and correct. So help me God.

(Signature) Lyle R. Danell

SUBSCRIBED AND SWORN TO before me this 24th day of April, 19 61

Exhibition E. Phillips  
Notary Public  
My commission expires June 18, 1963

