

STATE OF KANSAS
STATE CORPORATION COMMISSION

WELL PLUGGING RECORD

Take All Information Completely
Make Required Affidavit
Mail or Deliver Report to
Conservation Division
State Corporation Commission

P. O. Box 17027
Wichita, Kansas 67217

Rice County, Sec. 15 Twp. 20 Rge. 6 (E) W (W)

Location as "NE/CNW/SW" or footage from lines C SE SE

Lease Owner Koch Exploration Co.

Lease Name Johnson Well No. #3

Office Address Box 2256 ; Wichita, Ks. 67201

Character of Well (completed as Oil, Gas or Dry Hole) Oil

Date well completed May 19 65


Application for plugging filed June 19 74

Application for plugging approved June 19 74

Plugging commenced June 5 19 74

Plugging completed June 17 19 74

Reason for abandonment of well or producing formation Depleted

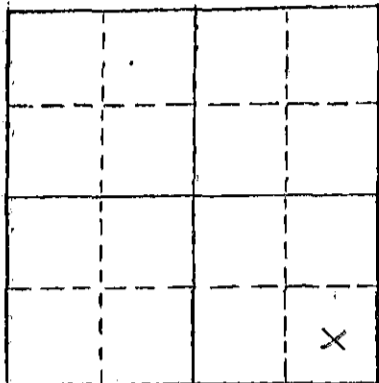

Locate well correctly on above
Section Plat

If a producing well is abandoned, date of last production 19

Was permission obtained from the Conservation Division or its agents before plugging was commenced? Yes

Name of Conservation Agent who supervised plugging of this well Gilbert Toman

Producing formation Miss. Chat Depth to top 3299 Bottom 3325 Total Depth of Well 3325 Feet

Show depth and thickness of all water, oil and gas formations.

OIL, GAS OR WATER RECORDS

CASING RECORD

FORMATION	CONTENT	FROM	TO	SIZE	PUT IN	PULLED OUT
				8 5/8"	192	None
				4 1/2"	3304	1200

Describe in detail the manner in which the well was plugged, indicating where the mud fluid was placed and the method or methods used in introducing it into the hole. If cement or other plugs were used, state the character of same and depth placed, from feet to feet for each plug set.

June 5, 1974 Plugged off bottom. Dumped sand to 3275'. Mixed and dumped 4 sx of cement.

June 17, 1974 Plugged off top. Set 15' rock bridge from 200' to 215'. Filled 8 5/8" surface casing from 200' to base of cellar with 3000 lb. P.S.I. ready-mix concrete.

RECEIVED
STATE CORPORATION COMMISSION
AUG 1 1974
CONSERVATION DIVISION
Wichita, Kansas

(If additional description is necessary, use BACK of this sheet)

Name of Plugging Contractor RUSS CASING PULLING, INC.

Address P. O. Box 1082 ; Great Bend, Kansas 67530

STATE OF Kansas COUNTY OF Sedgwick ss.
R. L. Rathbun (employed of owner) or (owner or operator) of the above-described

well, being first duly sworn on oath, says: That I have knowledge of the facts, statements, and matters herein contained and the leg of the above-described well as filed and that the same are true and correct. So help me God.

(Signature) R. L. Rathbun
Box 2256, Wichita, Ks. 67201 (Address)

SUBSCRIBED AND SWORN TO before me this 31st day of July 1974

LOREN B. CORLISS
NOTARY PUBLIC
Sedgwick County, Kansas
My Commission Expires July 27, 1977

My commission expires

R. L. Rathbun
Notary Public

DRILLER'S LOG

Rock Island
Johnson #3
C SE SE Sec. 15-20S-6W
Rice County, Kansas

Commenced: May 3, 1965

Completed: May 9, 1965

Set 8-5/8" surface casing at 192'
and cemented with 150 sacks HA5 Pozmix.

Set 4-1/2" production casing at 3303'
and cemented with 50 sacks cement.


<u>Formation</u>	<u>From</u>	<u>To</u>
Surface Clay and Shale	0	100
Green Shale and Redbed	100	192
Shale and Shells	192	824
Shale and Lime	824	2570
Lime	2570	3304 T.D.

I hereby certify that this is a true and correct log of the above captioned well as shown by the daily drilling reports.


James Tasheff

Subscribed and sworn to before me this 15th day of June, 1965.

My commission expires March 21, 1966

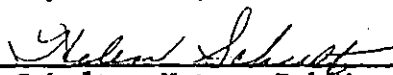
Helen Schultz, Notary Public

RECEIVED
STATE CORPORATION COMMISSION
APR 8 - 1974
CONSERVATION DIVISION
Wichita, Kansas