


STATE OF KANSAS  
STATE CORPORATION COMMISSION  
CONSERVATION DIVISION  
P. O. BOX 17027  
WICHITA, KANSAS 67217

FORM CP-4

WELL PLUGGING RECORD

Kiowa County, Sec. 25 Twp. 28S Rge. 19W (E) (W)

Location as "NE/CNWSW" or footage from lines SW SW  
Lease Owner PICKRELL DRILLING COMPANY  
Lease Name Heinze "A"  
Office Address Litwin Bldg., Suite 205 110 N. Market Wichita, Ks  
Character of Well (completed as Oil, Gas or Dry Hole) Dry Hole  
Date well completed 10-17 1975  
Application for plugging filed 10-17 1975  
Application for plugging approved 10-17 1975  
Plugging commenced 10-17 1975  
Plugging completed 10-17 1975  
Reason for abandonment of well or producing formation Dry Hole

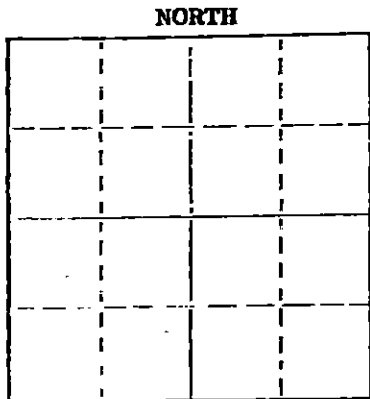

Locate well correctly on above Section Flat

If a producing well is abandoned, date of last production 19  
Was permission obtained from the Conservation Division or its agents before plugging was commenced? Yes

Name of Conservation Agent who supervised plugging of this well G. Russell Biberstein  
Producing formation \_\_\_\_\_ Depth to top \_\_\_\_\_ Bottom \_\_\_\_\_ Total Depth of Well 4970  
Show depth and thickness of all water, oil and gas formations.

OIL, GAS OR WATER RECORDS

CASING RECORD

FORMATION	CONTENT	FROM	TO	SIZE	PUT IN	PULLED OUT
				8 5/8	249	None

Describe in detail the manner in which the well was plugged, indicating where the mud fluid was placed and the method or methods used in introducing it into the hole. If cement or other plugs were used, state the character of same and depth placed, from \_\_\_\_\_ feet to \_\_\_\_\_ feet for each plug set.

35 sacks at 200'  
15 sacks at 40'  
2 sacks in Rate Hole Job comp. 2PM 10-17-75

(If additional description is necessary, use BACK of this sheet)  
Name of Plugging Contractor Pickrell Drilling Company  
Address Litwin Bldg., Suite 205 110 N. Market Wichita, Ks. 67202

STATE OF Kansas COUNTY OF Sedgwick ss.  
C. W. Sebitts

(employee of owner) or (owner or operator) of the above-described well, being first duly sworn on oath, says: That I have knowledge of the facts, statements, and matters herein contained and the log of the above-described well as filed and that the same are true and correct. So help me God.

(Signature) C. W. Sebitts  
Litwin Bldg., Suite 205 110 N. Market Wichita, Ks. 02

SUBSCRIBED AND SWORN to before me this 6 day of November, 1975

My commission expires \_\_\_\_\_  
STATE NOTARY PUBLIC  
HELEN L. MARTIN  
Sedgwick County, Ks.  
My Appmt. Exp. Aug. 19, 1979

Helen L. Martin  
Notary Public.

RECEIVED  
STATE CORPORATION COMMISSION

NOV 10 1975

CONSERVATION DIVISION  
Wichita, Kansas

ROTARY DRILLING LOG

COMPANY: PICKRELL DRILLING COMPANY  
Litwin Bldg., Suite 205 110 N. Market  
Wichita, Ks. 67202  
LOCATION: Heinze "A" #1  
150' S of SW SW 25-28S-19W  
Kiowa Co., Kansas  
CONTRACTOR: PICKRELL DRILLING COMPANY  
Wichita, Kansas

Rotary Drilling Commenced 10-1-75  
Rotary Drilling Completed 10-17-75

CASING RECORD: 8.5/8 surface casing set at 249' w/175sx. Date comp. 10-1-75.

LOG

(Figures indicate bottom of formation — measurements from top of rotary bushing.)

Clay Sd. & shale	242	Lime & Shale	4795
Shale	560	Lime	4820
Shale & Red bed	1238	Lime	4865
Shale	1275	Lime-Shale	4898
Shale	1560	Lime	4930
Shale & Shells	2110	Chert & Dolomite	4950
Shale & Shells	2368	Chert & Dolomite	RTD 4970
Lime & Shale	2535		
Lime & Shale	2605		
Lime & Shale	2785		
Lime & Shale	2940		
Lime & Shale	3080		
Lime & Shale	3265		
Lime & Shale	3400		
Lime & Shale	3535		
Lime & Shale	3660		
Lime & Shale	3775		
Lime w/shale	3825		
Lime & Shale	4032		
Lime & Shale	4067		
Lime w/shle	4132		
Lime:	4192		
Lime & Shale	4242		
Lime & Shale	4290		
Lime & Shale	4345		
Lime & Shale	4372		
Lime	4378		
Lime	4418		
Lime	4490		
Lime	4508		
Lime	4527		
Lime	4587		
Lime	4595		
Lime	4645		
Lime	4708		
Lime	4710		
Lime	4740		

STATE COMMISSION  
NOV 10 1975  
GENERAL INVESTIGATIVE DIVISION  
WICHITA, KANSAS

The undersigned, C. W. Sebitts, Attorney-in-Fact for PICKRELL DRILLING COMPANY, hereby certifies in behalf of said Company, that the above is a true and correct log of the formation encountered in drilling the above well as reflected by the Daily Drilling Reports.

PICKRELL DRILLING COMPANY  
By [Signature]  
C. W. Sebitts Attorney-in-Fact

STATE OF KANSAS }  
COUNTY OF SEDGWICK } ss.

On this 6 day of November, 1975, before me the undersigned, a Notary Public, in and for the County and State aforesaid, personally appeared C. W. Sebitts, to me known to be the identical person who subscribed the name of PICKRELL DRILLING COMPANY to the foregoing instrument as its Attorney-in-Fact and acknowledged to me that he executed the same as his free and voluntary act and deed, and as the free voluntary act and deed of such company, for the uses and purposes therein set forth.

Given under my hand and seal of office the day and year last above written.

STATE NOTARY PUBLIC  
HELEN L. MARTIN  
Sedgwick County, Ks.  
My Appmt. Exp. Aug. 1974

[Signature]  
Helen L. Martin Notary Public

ion expires: