


STATE OF KANSAS
STATE CORPORATION COMMISSION

WELL PLUGGING RECORD

Give All Information Completely
Make Required Affidavit
Mail or Deliver Report to
Conservation Division
State Corporation Comm.
245 North Water
Wichita, KS 67202

Kiowa County, Sec. 13 Twp. 28S Rge. 20W E/W
Location as "NE/CNW $\frac{1}{4}$ /SW $\frac{1}{4}$ " or footage from lines
C SE NE

Lease Owner Petroleum, Inc.
Lease Name RALSTIN Well No. 1
Office Address 800 R. H. Garvey Bldg. Wichita, Kansas 67202
Character of Well (Completed as Oil, Gas or Dry Hole)
Dry Hole

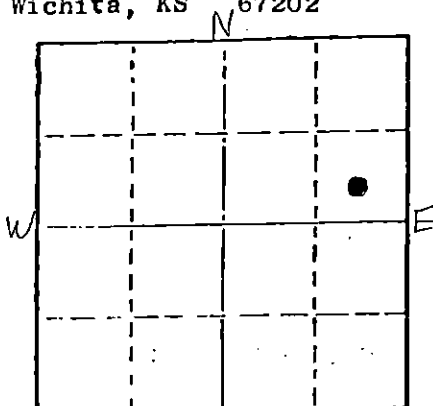

Locate well correctly on above
Section Plot

Date Well completed January 11 1977
Application for plugging filed (Verbally) January 11 1977
Application for plugging approved (Verbally) January 11 1977
Plugging commenced January 11 1977
Plugging completed January 11 1977
Reason for abandonment of well or producing formation
No commercial quantity of oil or gas encountered
If a producing well is abandoned, date of last production
19

Was permission obtained from the Conservation Division or
its agents before plugging was commenced? Yes

Name of Conservation Agent who supervised plugging of this well Clarence Thomas - Garden City, KS
Producing formation _____ Depth to top _____ Bottom _____ Total Depth of Well _____
Show depth and thickness of all water, oil and gas formations.

OIL, GAS OR WATER RECORDS

CASING RECORD

FORMATION	CONTENT	FROM	TO	SIZE	PUT IN	PULLED OUT

Describe in detail the manner in which the well was plugged, indicating where the mud fluid
was placed and the method or methods used in introducing it into the hold. If cement or other
plugs were used, state the character of same and depth placed, from _____ feet to
_____ feet for each plug set.

T. D. 4954'
Set 1st plug at 600' with 50 sx.
2nd plug at 40' with 15 sx.
5 sx. in Rathole.

Plug was down at 5:00 p.m. 1-11-77
State Plugger - Clarence Thomas - Garden City, Kansas

(If additional description is necessary, use BACK of this sheet)

Name of Plugging Contractor Abercrombie Drilling, Inc.

STATE OF Kansas COUNTY OF Sedgwick ss.
Jack L. Partridge, Asst. Sec.-Treas. (employee of owner) or (owner or operator) of the above-described
well, being first duly sworn on oath, says: That I have knowledge of the facts, statements, and matters herein contained and the log of the
above-described well as filed and that the same are true and correct. So help me God.

(Signature) Jack L. Partridge
801 Union Center, Wichita, Kansas 67202
(Address)

SUBSCRIBED AND SWORN TO before me this 14th day of January 1977

My commission expires _____

Kathy S. Goertz
Kathy S. Goertz Notary Public.



1-21-77
JAN 21 1977
CONS. DIV. S. COR.
Wichita, Kansas

CONTRACTOR'S WELL LOG

OPERATOR: Petroleum, Inc.
 CONTRACTOR: Abercrombie Drilling, Inc.
 WELL NAME: RALSTIN #1
 LOCATION: C SE NE, Section 13-28S-20W
 Kiowa County, Kansas
 SPUD DATE: 12-31-76
 COMPLETION DATE: 1-11-77

0	225	Surface Sand
225	630	Shale & Sand
630	683	Sand
683	714	Anhydrite
714	1395	Shale & Red Beds
1395	1840	Shale & Shells
1840	2225	Shale & Lime
2225	2640	Lime & Shale
2640	3435	Shale & Lime
3435	3595	Lime & Shale
3595	3920	Shale & Lime
3920	4135	Lime & Shale
4135	4265	Shale & Lime
4265	4365	Lime & Shale
4365	4575	Shale & Lime
4575	4648	Lime
4648	4715	Lime & Shale
4715	4780	Shale & Lime
4780	4825	Lime & Shale
4825	4954	Lime
	4954	Rotary Total Depth

Spud at 9:30 p.m. 12-31-76. Cut 630' of 12 1/4" hole. Rathole ahead 7 7/8" to 1395'. Ran 15 jts. of 8 5/8" surface casing. (Tally 600') Set at 607'. Cemented with 200 sx. of 50/50 posmix, 2% gel, 3% Ca. Cl. followed with 200 sx. of common cement, 3% Ca. Cl., 2% gel. Cement did circulate. Job complete at 11:00 p.m. 1-01-77.

T.D. 4954', Plug with 50 sx. at 600', 15 sx. at 40', 5 sx. in Rathole. Plug was down at 5:00 p.m. 1-11-77. State Plugger - Clarence Thomas - Garden City, Kansas.

SAMPLE TOPS:

Anhydrite 1228' (+1066)
 B/Anhydrite 1276' (+1018)

STATE OF KANSAS)
) SS
 COUNTY OF SEDGWICK)

Jack L. Partridge, Assistant Secretary-Treasurer of Abercrombie Drilling, Inc., does hereby state that the above and foregoing is a true and correct copy of the log of the RALSTIN #1, C SE NE, Section 13-28S-20W, Kiowa County, Kansas.

ABERCROMBIE DRILLING, INC.

STATE OF KANSAS
 DEPARTMENT OF REVENUE
 JAN 21 1977
 CONSERVATION

BY: Jack L. Partridge

Subscribed and sworn to before me, Kathy S. Goertz, Notary Public, in and for the aforesaid county and state as of this 14th day of January, 1977.



Kathy S. Goertz
 Kathy S. Goertz, Notary Public