


Give All Information Completely
Make Required Affidavit
Mail or Deliver Report to:
Conservation Division
State Corporation Commission
800 Biting Building
Wichita, Kan.

WELL PLUGGING RECORD

Kiowa County, Sec. 23 Twp. 28S Rge. 20 (E) (W)
Location as "NE/CNW/SW" or footage from lines C NE/4 NE/4 NE/4
Lease Owner Davidor & Davidor
Lease Name Sherer Well No. 1
Office Address 4515 N. Santa Fe, Oklahoma City, Oklahoma
Character of Well (completed as Oil, Gas or Dry Hole) Dry Hole
Date well completed 5-23-56 19
Application for plugging filed 5-23-56 19
Application for plugging approved 5-23-56 19
Plugging commenced 3:00 P.M. 5-23-56 19
Plugging completed 4:00 P.M. 5-23-56 19
Reason for abandonment of well or producing formation Dry Hole

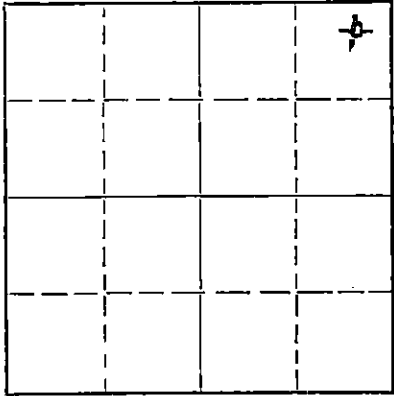

Locate well correctly on above Section Plat

If a producing well is abandoned, date of last production _____ 19____
Was permission obtained from the Conservation Division or its agents before plugging was commenced? yes

Name of Conservation Agent who supervised plugging of this well S. S. Greider, Wichita, Kansas
Producing formation _____ Depth to top _____ Bottom _____ Total Depth of Well 5027 Feet
Show depth and thickness of all water, oil and gas formations.

OIL, GAS OR WATER RECORDS

CASING RECORD

FORMATION	CONTENT	FROM	TO	SIZE	PUT IN	PULLED OUT
				8-5/8	279'	- 0 -

Describe in detail the manner in which the well was plugged, indicating where the mud fluid was placed and the method or methods used in introducing it into the hole. If cement or other plugs were used, state the character of same and depth placed, from _____ feet to _____ feet for each plug set.

Filled with heavy mud from bottom to 275'. Set Halliburton plug, 1/3 sack hulls, 15 sacks cement. Filled with heavy mud to 40'. Set Halliburton plug, 1/3 sack hulls, 10 sacks cement.

RECEIVED
STATE CORPORATION COMMISSION
MAY 25 1956
CONSERVATION DIVISION
Wichita, Kansas
5-25-56

(If additional description is necessary, use BACK of this sheet)
Name of Plugging Contractor D & M Drilling Company, Inc.
Address P. O. Box 247, Great Bend, Kansas

STATE OF Kansas, COUNTY OF Barton, ss.
Don S. Packer (employee of owner) or (owner or operator) of the above-described well, being first duly sworn on oath, says: That I have knowledge of the facts, statements, and matters herein contained and the log of the above-described well as filed and that the same are true and correct. So help me God.

(Signature) [Signature]
Box 247, Great Bend, Kansas
(Address)

SUBSCRIBED AND SWORN TO before me this 24th day of May, 1956

My commission expires February 23, 1959. Marie Nicolet Notary Public.

PLUGGING
FILE SEC 23 T 28 R 20W
BOOK PAGE 64 LINE 8

SHELFER #1

C - NE/4 NE/4 NE/4 23-252-20W Kiowa County, Kansas

Rigged up Rotary Tools 5/5/56

Ran 15 Jts. (300.85') 8-5/8" Used Surface Pipe set at 279.28. Cemented with 250 sacks cement with 2% C.C.

Tore down Rotary Tools 5/23/56

Ran 158 Jts. (5027') 4-1/2" Casing set @ 5027'.

<u>FORMATION</u>	<u>FROM</u>	<u>TO</u>
Sand, shale & shells	0'	311'
Shale, shells & sand streaks	311	800
Redbed & shells	800	1215
Redbed	1215	1430
Shale & shells	1430	2136
Line & shale	2136	2520
Shale, line & chert	2520	2580
Line	2580	2705
Line & shale	2705	2775
Shale, line & chert	2775	2865
Line & shale	2865	3340
Shale	3340	3480
Shale w/line streaks	3480	3545
Line & shale	3545	4132
Line, sand & shale	4132	4228
Line & shale	4228	4328
Line	4328	4700
Line & shale	4700	4736
Line	4736	4806
Line & shale	4806	4846
Line, sand & shale	4846	4873
Line & shale	4873	4950
Line, shale & chert	4950	5027 T.D.

I, Don S. Facker, do hereby certify that the foregoing log is true and correct, to the best of my knowledge and belief.

Don S. Facker

Don S. Facker

Subscribed and sworn to before me this 24th day of May, 1956.

Marie Nicolet

Notary Public

My commission expires February 23, 1959.

RECEIVED
STATE CORPORATE COMMISSION
MAY 25 1956
CONSERVATION DIVISION
STANLEY HANSON

PLUGGING
FILE SEC. 23 T. 28 R. 20W
BOOK PAGE 64 LINE 8