

STATE OF KANSAS  
STATE CORPORATION COMMISSION

WELL PLUGGING RECORD

Give All Information Completely  
Make Required Affidavit  
Mail or Deliver Report to  
Conservation Division  
State Corporation Comm.  
245 North Water  
Wichita, KS 67202

Kiowa County, Sec. 25 Twp. 28S Rge. 20W E/W  
Location as "NE/CNW $\frac{1}{2}$ /SW $\frac{1}{2}$ " or footage from lines  
NE NE

Lease Owner PICKRELL DRILLING COMPANY  
Lease Name SIDENER Well No. 1  
Office Address 205 LITWIN BLDG., WICHITA, KS. 67202  
Character of Well (Completed as Oil, Gas or Dry Hole)  
Dry Hole


Date Well completed 1-25-77 19  
Application for plugging filed 1-25-77 19  
Application for plugging approved 1-25-77 19  
Plugging commenced 1-25-77 19  
Plugging completed 1-25-77 19

Reason for abandonment of well or producing formation  
Dry Hole

If a producing well is abandoned, date of last production  
19

Was permission obtained from the Conservation Division or  
its agents before plugging was commenced? Yes

Name of Conservation Agent who supervised plugging of this well G. R. Biberstein  
Producing formation \_\_\_\_\_ Depth to top \_\_\_\_\_ Bottom \_\_\_\_\_ Total Depth of Well 5080  
Show depth and thickness of all water, oil and gas formations.

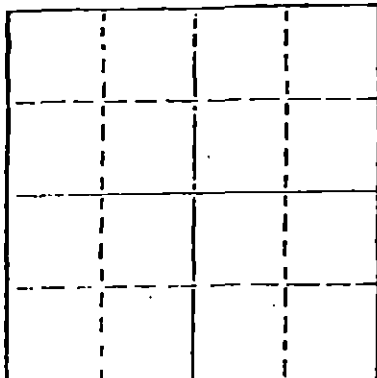

Locate well correctly on above  
Section Flat

OIL, GAS OR WATER RECORDS

CASING RECORD

FORMATION	CONTENT	FROM	TO	SIZE	PUT IN	PULLED OUT
				8 5/8	257	None

Describe in detail the manner in which the well was plugged, indicating where the mud fluid was placed and the method or methods used in introducing it into the hold. If cement or other plugs were used, state the character of same and depth placed, from \_\_\_\_\_ feet to \_\_\_\_\_ feet for each plug set.

40 sacks at 270'  
10 sacks at 40'

Comp. at 10AM 1-25-77

RECEIVED  
STATE CORPORATION COMMISSION

FEB 11 1977

CONSERVATION DIVISION  
Wichita, Kansas

(If additional description is necessary, use BACK of this sheet)

Name of Plugging Contractor Pickrell Drilling Company, 205 Litwin Bldg., Wichita, Ks. 67202

STATE OF Kansas COUNTY OF Sedgwick, ss.  
C. W. Sebitts (employee of owner) or (owner or operator)

of the above-described well, being first duly sworn on oath, says: That I have knowledge of the facts, statements, and matters herein contained and the log of the above-described well as filed and that the same are true and correct. So help me God.

(Signature)

BY: Carl W. Sebitts  
205 Litwin Bldg. Wichita, Ks. 67202  
(Address)

SUBSCRIBED AND SWORN TO before me this 8 day of January, 1977

My commission expires

Jo Ann Sarver  
Notary Public.



**ROTARY DRILLING LOG**

COMPANY: PICKRELL DRILLING COMPANY  
 205 LITWIN BLDG.  
 WICHITA, KS. 67202  
 LOCATION: Sidener "A" #1  
 NE NE Sec. 25-28S-20W  
 Kiowa Co., Kansas  
 CONTRACTOR: **PICKRELL DRILLING COMPANY**  
 Wichita, Kansas

Rotary Drilling Commenced 1-12-77  
 Rotary Drilling Completed 1-25-77

CASING RECORD: Set surface casing of 8 5/8" at 257' with 200 sacks.

**LOG**

(Figures indicate bottom of formation — measurements from top of rotary bushing.)

Shale & Sand	180
Shale	266
Shale	675
Shale & Sand	1275
Shale	1290
Shale	1300
Shale	1820
Lime & Shale	2120
Lime & Shale	2380
Lime & Shale	2528
Lime & Shale	2645
Lime & Shale	2800
Lime & Shale	2936
Lime & Shale	3025
Lime & Shale	3115
Lime & Shale	3234
Lime & Shale	3355
Lime & Shale	3500
Lime & Shale	3600
Lime	3680
Lime	3785
Lime & Shale	3955
Lime & Shale	4090
Lime & Shale	4210
Lime & Shale	4299
Lime & Shale	4380
Lime	4445
Lime	4540
Lime & Shale	4625
Lime & Shale	4690
Lime & Shale	4754
Lime & Shale	4794
Lime & Shale	4854
Lime & Shale	4922
Lime	4984
Lime	4995
Lime	5030
Lime	5080

RECEIVED  
 STATE CORPORATION COMMISSION  
 FEB 11 1977  
 CONSERVATION DIVISION  
 Wichita, Kansas

The undersigned, C. W. Sebitts, Attorney-in-Fact for PICKRELL DRILLING COMPANY, hereby certifies in behalf of said Company, that the above is a true and correct log of the formation encountered in drilling the above well as reflected by the Daily Drilling Reports.

PICKRELL DRILLING COMPANY

By [Signature]  
 Attorney-in-Fact  
 C. W. Sebitts

STATE OF KANSAS }  
 COUNTY OF SEDGWICK } ss.:

On this 8 day of January, 19 77, before me the undersigned, a Notary Public, in and for the County and State aforesaid, personally appeared C. W. Sebitts, to me known to be the identical person who subscribed the name of PICKRELL DRILLING COMPANY to the foregoing instrument as its Attorney-in-Fact and acknowledged to me that he executed the same as his free and voluntary act and deed, and as the free and voluntary act and deed of such company, for the uses and purposes therein set forth.

Given under my hand and seal of office the day and year last above written.

My commission expires: \_\_\_\_\_

[Signature]  
 Notary Public  
 Jo Ann Sarver

