

STATE OF KANSAS
STATE CORPORATION COMMISSION

WELL PLUGGING RECORD

Give All Information Completely
Make Required Affidavit
Mail or Deliver Report to
Conservation Division
State Corporation Comm.
245 North Water
Wichita, KS 67202

Kiowa County. Sec. 32 Twp. 28S Rge. 20W
Location as "NE/CNW $\frac{1}{4}$ /SW $\frac{1}{4}$ " or footage from lines
C SE SE

Lease Owner Trich, Fletcher, & Antares Oil Corporation

Lease Name Mabel Hammer Well No. 1

Office Address c/o Wenert Trich, Box 1408,
Longview, Texas 75601

Character of Well (Completed as Oil, Gas or Dry Hole) _____

Dry Hole

Date Well completed June 5, 1979

Application for plugging filed June 5, 1979

Application for plugging approved June 5, 1979

Plugging commenced June 5, 1979

Plugging completed June 5, 1979

Reason for abandonment of well or producing formation _____

Dry Hole.

If a producing well is abandoned, date of last production
_____ 19____

Was permission obtained from the Conservation Division or
its agents before plugging was commenced? Yes

Name of Conservation Agent who supervised plugging of this well Wm. T. Owen
Producing formation _____ Depth to top _____ Bottom _____ Total Depth of Well 5114'

Show depth and thickness of all water, oil and gas formations.

OIL, GAS OR WATER RECORDS

CASING RECORD

FORMATION	CONTENT	FROM	TO	SIZE	PUT IN	PULLED OUT
		0'	169'	13"	169'	None
		0'	605'	8-5/8"	595.23'	None

Describe in detail the manner in which the well was plugged, indicating where the mud fluid was placed and the method or methods used in introducing it into the hold. If cement or other plugs were used, state the character of same and depth placed, from _____ feet to _____ feet for each plug set.

Plugged with 40 sacks cement at 540',
solid bridge plug and 12 sacks cement
at 40', and 3 sacks cement in rat hole.

(If additional description is necessary, use BACK of this sheet)

Name of Plugging Contractor Halliburton Cementing Company.

STATE OF KANSAS COUNTY OF SEDGWICK, ss.
John D. Knightley (Agent) (employee of owner) or (owner or operator)

of the above-described well, being first duly sworn on oath, says: That I have knowledge of the facts, statements, and matters herein contained and the log of the above-described well as filed and that the same are true and correct. So help me God.

(Signature)

[Signature]
221 S. Broadway, Wichita, Kansas 67202
(Address)

SUBSCRIBED AND SWORN TO before me this 19th day of June, 19 79


My commission expires March 12, 1983

[Signature]
Notary Public.

RECEIVED
STATE CORPORATION COMMISSION

JUN 20 1979

CONSERVATION DIVISION
Wichita, Kansas

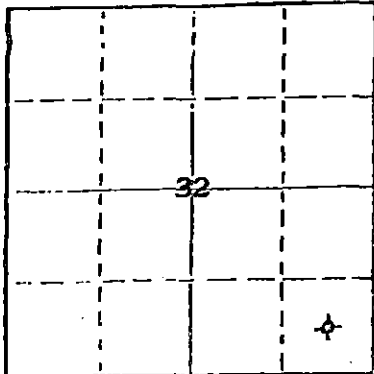

Locate well correctly on above Section Plat

Trich, Fletcher, & Antares
Oil Corporation
c/o Wenert Trich
Box 1408
Longview, Texas 75601

- Mabel Hammer #1
C SE SE Sec. 32-28S-20W
Kiowa County, Kansas

Contractor: D. R. Lauck Oil Company, Inc.
221 S. Broadway, Suite 400
Wichita, Kansas 67202

Commenced: May 23, 1979
Completed: June 5, 1979

Drillers Log

Red Bed	1026
Shale	1575
Shale & Shells	2420
Shale	2620
Shale & Lime	2840
Shale & Shells	3075
Shale & Lime	3245
Shale & Shells	3670
Shale & Lime	4360
Shale	4550
Lime	5114 RTD

RECEIVED
STATE CORPORATION COMMISSION

JUN 20 1979

CONSERVATION DIVISION
Wichita, Kansas