


Give All Information Completely
Make Required Affidavit
Mail or Deliver Report to:
Conservation Division
State Corporation Commission
212 North Market, Insurance Bldg.
Wichita, Kansas

WELL PLUGGING RECORD

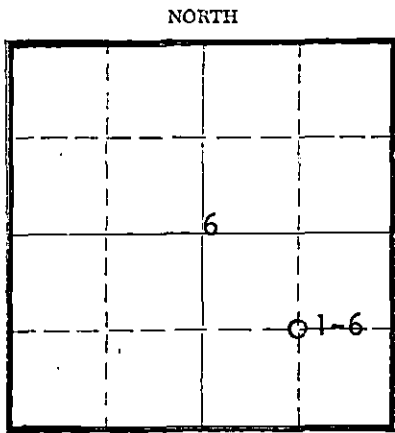

Locate well correctly on above Section Plat

Kiowa County, Sec. 6 Twp. 30 Rge. 16 (E) W (W)

Location as "NE/CNW/SW" or footage from lines 1320' FSL & 1320' FEL
Lease Owner Union Oil Company of California
Lease Name Robbins Well No. 1-6
Office Address 7th Floor So. Bldg. 2000 Classen Center - Okla. City, Okla.
Character of Well (completed as Oil, Gas or Dry Hole) Dry Hole
Date well completed August 1, 1968
Application for plugging filed August 2, 1968
Application for plugging approved August 5, 1968
Plugging commenced August 6, 1968
Plugging completed August 7, 1968
Reason for abandonment of well or producing formation Dry Hole

If a producing well is abandoned, date of last production - 19-
Was permission obtained from the Conservation Division or its agents before plugging was commenced? Yes

Name of Conservation Agent who supervised plugging of this well Ralph Warren
Producing formation - Depth to top - Bottom - Total Depth of Well 4750' Feet
Show depth and thickness of all water, oil and gas formations.

OIL, GAS OR WATER RECORDS

CASING RECORD

| FORMATION | CONTENT | FROM | TO | SIZE | PUT IN | PULLED OUT |
|-----------|---------|------|----|--------|--------|------------|
| - | - | - | - | 8-5/8" | 700' | None |
| | | | | 4-1/2" | 4750' | 2812' |
| | | | | | | |
| | | | | | | |
| | | | | | | |
| | | | | | | |

Describe in detail the manner in which the well was plugged, indicating where the mud fluid was placed and the method or methods used in introducing it into the hole. If cement or other plugs were used, state the character of same and depth placed, from _____ feet to _____ feet for each plug set.

Halliburton squeezed perforations in 4 1/2" casing 4566'-4600' w/50 sx. 50/50 pozmix (15.2#) at 2700# Max. T.P. Reversed out 2 1/2" sx. cmt. leaving 48 sacks across perforations. Tagged top of cement inside 4 1/2" casing @ 4381'. Cut 4 1/2" casing off @ 2812' & pulled 2812' of 4 1/2" casing. Mudded hole to 250', set 10' rock bridge from 250' to 240', spotted 25 sx. cement plug from 240' to 165', mudded hole from 165' to 40', set 10' rock bridge plug from 40' to 30', spotted 10 sx. cement plug from 30' to base of cellar. Cut 8-5/8" casing off & welded steel cap on top of surface casing. Well Plugged & abandoned 4-7-68.

RECEIVED
STATE CORPORATION COMMISSION
AUG 15 1968
CONSERVATION DIVISION
Wichita, Kansas

(If additional description is necessary, use BACK of this sheet)
Name of Plugging Contractor Russ Casing Pulling Inc.
Address Box 1082 - Great Bend, Kansas 67530

STATE OF Oklahoma, COUNTY OF Oklahoma, ss.
Gary J. Chenier (employee of owner) ~~XXXXXXXXXXXX~~ of the above-described well, being first duly sworn on oath, says: That I have knowledge of the facts, statements, and matters herein contained and the log of the above-described well as filed and that the same are true and correct. So help me God.

(Signature) Gary J. Chenier
Gary J. Chenier - District Drig. Supt.
7th Floor South Bldg. 2000 Classen Center
Oklahoma City, Oklahoma 73106

SUBSCRIBED AND SWORN TO before me this 14th day of August, 1968

My commission expires 4/14/72

John [Signature]
Notary Public.

WELL LOG

COMPANY Union Oil Company of California

SEC. 6 T. 30 S. 16 W

FARM Robbins

NO. 1-6

LOC. 1320' FS & EL


TOTAL DEPTH 4753

COUNTY Kiowa, Kansas

COMM. 7/2/68

COMP. 7/17/68

CONTRACTOR Garvey Drilling Company

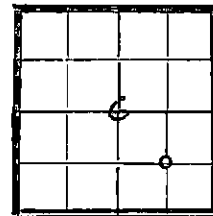

CASING 8 5/8" @ 750' w/350 sx
4 1/2" @ 4750' w/135 sx

ELEVATION

PRODUCTION

FIGURES INDICATE BOTTOM OF FORMATIONS

- 70' Sand & Gravel
- 750' Red Bed
- 783' Anhydrite
- 810' Red Bed
- 1565' Red Bed, Shale & Shells
- 1760' Shale & Shells
- 2000' Anhydrite, Lime & Shale
- 2615' Lime & Shale
- 2817' Lime
- 4125' Lime & Shale
- 4500' Lime
- 4551' Lime & Shale
- 4560' Lime
- 4610' Chert
- 4657' Lime & Chert
- 4705' Shale & Lime
- 4753' Lime & Shale
- 4753' RTD

RECEIVED
STATE CORPORATION COMMISSION
AUG 15 1968
CONSERVATION DIVISION
Wichita, Kansas

State of Kansas }
County of Barton } ss

I, Eunice McEachern of Garvey Drilling Company

upon oath state the above and foregoing is a true and correct copy of the log of the Robbins 1-6 well.

Eunice McEachern

Subscribed and sworn to before me this 22 day of July 19 68

My Commission Expires: November 5, 1969

Richard St. Boys
NOTARY PUBLIC