

WELL PLUGGING RECORD


FORMATION PLUGGING RECORD

STATE OF KANSAS STATE CORPORATION COMMISSION Give All Information Completely Make Required Affidavit Mail or Deliver Report to: Conservation Division State Corporation Commission 800 Bittling Building Wichita, Kansas

Strike out upper line when reporting plugging of formations.

Rice County, Sec. 26 Twp. 20 Rge. (E) 6 (W)

Location as "NE 1/4 NW 1/4 SW 1/4" or footage from lines. C S/2 SW SW Lease Owner: Donald T. Ingling, et al Lease Name: Johannsen Well No.: 1 Office Address: 708 Fourth Nat'l. Bldg., Wichita, Kansas Character of Well (completed as Oil, Gas or Dry Hole): Dry Hole Date well completed: 11/19/48 Application for plugging filed: 12/1/48 Application for plugging approved: 12/4/48 Plugging commenced: 12/6/48 Plugging completed: 12/7/48 Reason for abandonment of well or producing formation:

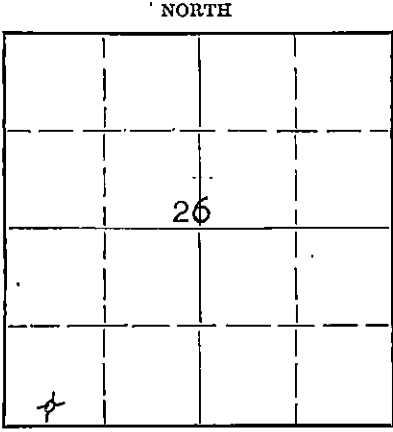

Locate well correctly on above Section Plat

If a producing well is abandoned, date of last production: 19... Was permission obtained from the Conservation Division or its agents before plugging was commenced?: Yes

Name of Conservation Agent who supervised plugging of this well: Mr. Ruel Durkee, McPherson, Kansas Producing formation: Depth to top: Bottom: Total Depth of Well: 3419 Feet Show depth and thickness of all water, oil and gas formations.

OIL, GAS OR WATER RECORDS

CASING RECORD

Table with 7 columns: Formation, Content, From, To, Size, Put In, Pulled Out. Row 1: Formation (blank), Content (blank), From (blank), To (blank), Size (8 5/8), Put In (90), Pulled Out (None)

Describe in detail the manner in which the well was plugged, indicating where the mud fluid was placed and the method or methods used in introducing it into the hole. If cement or other plugs were used, state the character of same and depth placed, from... feet to ... feet for each plug set.

Run wood plug to 3357' - bridged hole with 10' of rock on top of plug - dumped 5 sacks cement on bridge - ripped pipe loose at 2705' - laid pipe down and mudded hole to 175' - rock bridge at 175' to 165' - 15 sacks cement to 120' - mudded hole to 10' - then cemented to base of cellar.

12-21-1948

RECEIVED

DEC 21 1948

STATE CORPORATION COMMISSION KANSAS

(If additional description is necessary, use BACK of this sheet)

Correspondence regarding this well should be addressed to: Donald T. Ingling Address: 708 Fourth Nat'l. Bldg., Wichita, Kansas

I, W. W. Wright, of the County of Sedgwick, State of Kansas, ss.

(employee of owner) or (owner or operator) of the above-described well, being first duly sworn on oath, says: That I have knowledge of the facts, statements, and matters herein contained and the log of the above-described well as filed and that the same are true and correct. So help me God.

(Signature) [Signature] 708 Fourth Nat'l. Bldg., Wichita, Kans. (Address)

SUBSCRIBED AND SWORN to before me this 15th day of December, 1948

[Signature] Notary Public.

Commission expires: 6/7/52

22-2625 2-48-15M

PLUGGING FILE SEC 26 T 20 R 6 E BOOK PAGE 76 LINE 38

WELL LOG JOHANNSEN NO. 1

Donald T. Ingling, et al - Lease Owners Sec. 26, Twp. 20, Range 6W

Donald T. Ingling - Contractor Location: 760' E of W Line
330' N of S Line

Total Depth: 3357' (Rotary) County: Rice (Kansas)

Commenced: October 17, 1948
Completed: November 3, 1948 Elevation: 1594' D.F.

Casing: 90' of 8 5/8" Production:
3357' of 5 1/2"

Figures below indicated bottom of formation:

15	Surface	2775	Lime
20	Iron Pyrite	2802	Shale
590	Shale & Shells	2900	Lime
745	Salt & Shale	2950	Lime - Broken Streaks
850	Lime & Shale	3240	Lime
	Streaks of Sand (Hard)	3270	Lime - Streaks of Shale
1310	Sandy Lime	3305	Shale
1330	Shale & Shells	3354	Shale - Chirty Streaks
2270	Lime & Shale	3355	Mississippi
2540	Lime		
2590	Lime - Broken	3357	TOTAL DEPTH
2730	Lime & Shale		

I hereby certify that this is a true and correct log of the abovementioned Well.

DONALD T. INGLING

STATE OF KANSAS |
SEDGWICK COUNTY | SS.

DEC 21 1948

Subscribed and sworn to before me, a Notary Public in said County and State this 9th day of November, 1948.

STATE OF KANSAS
NOTARY PUBLIC

PLUGGING
FILE SEC 212T 20 R 6W
BOOK PAGE 71 LINE 34

Notary Public

My Commission Expires June 7, 1952.