


Give All Information Completely
Make Required Affidavit
Mail or Deliver Report to:
Conservation Division
State Corporation Commission
800 Bittling Building
Wichita, Kansas

WELL PLUGGING RECORD

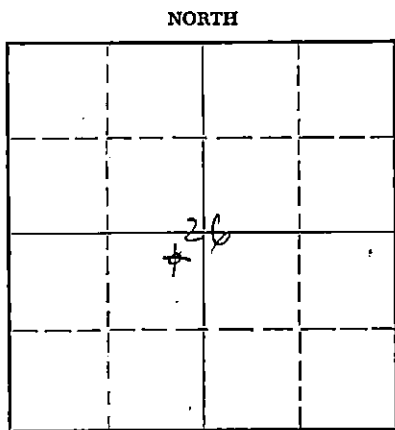

Locate well correctly on above Section Plat

Stafford County, Sec. 26 Twp. 20 Rge. 6 (X) (W)
Location as "NE/CNW&SW" or footage from lines NE NE SW
Lease Owner Petroleum, Inc.
Lease Name Lindholm Well No. 1
Office Address 305 East Third, Wichita, Kansas
Character of Well (completed as Oil, Gas or Dry Hole) Dry Hole
Date well completed October 31, 19 53
Application for plugging filed October 31, 19 53
Application for plugging approved October 31, 19 53
Plugging commenced October 31, 19 53
Plugging completed October 31, 19 53

Reason for abandonment of well or producing formation Dry Hole

If a producing well is abandoned, date of last production 19

Was permission obtained from the Conservation Division or its agents before plugging was commenced? Yes

Name of Conservation Agent who supervised plugging of this well Mr. M. A. Rives

Producing formation _____ Depth to top _____ Bottom _____ Total Depth of Well 3424 Feet

Show depth and thickness of all water, oil and gas formations.

OIL, GAS OR WATER RECORDS

CASING RECORD

| FORMATION | CONTENT | FROM | TO | SIZE | PUT IN | PULLED OUT |
|-----------|---------|------|----|--------|--------|------------|
| | | | | 8 5/8" | 219' | None |
| | | | | | | |
| | | | | | | |
| | | | | | | |
| | | | | | | |

Describe in detail the manner in which the well was plugged, indicating where the mud fluid was placed and the method or methods used in introducing it into the hole. If cement or other plugs were used, state the character of same and depth placed, from _____ feet to _____ feet for each plug set.

Mudded up to 215' and set wooden plug at 215'. Placed 1/4 sack hulls on top of plug at 215'. Cemented and displaced through drill pipe 20 sacks cement onto plug and hulls at 215'. Mudded up to 40' and set second plug at 40'. Filled hole to bottom of well cellar with 10 sacks cement.

(If additional description is necessary, use BACK of this sheet)

Name of Plugging Contractor Garvey Drilling Company
Address R.R. #2, Great Bend, Kansas

STATE OF KANSAS, COUNTY OF SEDGWICK, ss.
W.W. Fisher (employee of owner) or (owner or operator) of the above-described well, being first duly sworn on oath, says: That I have knowledge of the facts, statements, and matters herein contained and the log of the above-described well as filed and that the same are true and correct. So help me God.

(Signature) W.W. Fisher
305 East Third, Wichita, Kansas
(Address)

SUBSCRIBED AND SWORN to before me this 12th day of November, 19 53

My commission expires October 13, 1954

Charlton Meislin
Notary Public.
RECEIVED
3-53-20M
11-13-1953

PLUGGING
FILE SEC 26 T 20 R 6 W
BOOK PAGE 140 LINE 27

DRILLER'S LOG LINDHOLM #1

15.159.00091.0000

Petroleum Inc., Operator

Section 26, Twp. 20, Rge. 6W

Garvey Drilling Company, Contractor

Location: NE NE SW

Drilling Commenced: October 21, 1953

County: Rice County, Kansas

Drilling Completed: October 31, 1953

Production: D & A

Casing Record: 8 5/8" @ 219' w/150 sax

R.T.D.: 3424'

Figures below indicate bottom of formation:

| | |
|------|--------------------------|
| 35 | Red Rock, Red Bed & Sand |
| 75 | Sand & Red Bed |
| 100 | Red Bed & Shale |
| 180 | Red Rock & Shale |
| 219 | Shale & Shells |
| 315 | Red Bed |
| 335 | Anhydrite |
| 700 | Shale & Shells |
| 2845 | Lime & Shale |
| 3210 | Lime |
| 3345 | Lime & Shale |
| 3375 | Lime & Chert |
| 3424 | Chert |

Tops:

| | |
|----------------|--------------|
| Lansing: | 2792 (-1198) |
| Conglomerate: | 3348 (-1754) |
| Mississippian: | 3358 (-1764) |
| Kindor Hook: | 3418 (-1824) |

R.T.D.: 3424'

I hereby certify that this is a true and correct log of the above mentioned well.

PETROLEUM, INC.

By W. J. Tibb

STATE OF KANSAS)
) SS:
COUNTY OF SEDGWICK)

Subscribed to and sworn to before me, a Notary Public, in said County and State, this 12th day of November, 1953.

Charlotte Mason
Notary Public

My commission expires: October 13, 1954

PLUGGING
 FILE SEC 26 T 20 R 6W
 BOOK PAGE 140 LINE 27