

CARD MUST BE TYPED

State of Kansas
NOTICE OF INTENTION TO DRILL
(see rules on reverse side)

CARD MUST BE SIGNED

Starting Date: January 1 1985
month day year

API Number 15-097-21,103-0000

OPERATOR: License # 7044

SW NE SE Sec 27 Twp 28 S, Rge 19
(location) East West

Name SABINE CORPORATION

Address 6401 NW Grand Blvd., Suite 500

City/State/Zip Oklahoma City, OK 73116

Contact Person Vince J. Grass

Phone (405) 843-0620

CONTRACTOR: License # 5657

Name Slawson Drilling Company

City/State 200 Douglas Blvd., Wichita, KS 67202

Well Drilled For: Well Class: Type Equipment:

- Oil Swd Infield Mud Rotary
- Gas Inj Pool Ext. Air Rotary
- OWWO Expl Wildcat Cable

If OWWO: old well info as follows:

Operator

Well Name

Comp Date Old Total Depth

Projected Total Depth 5000 feet

Projected Formation at TD Mississippi

Expected Producing Formations Lansing & Kansas City

1750 Ft North from Southeast Corner of Section
990 Ft West from Southeast Corner of Section
(Note: Locate well on Section Plat on reverse side)

Nearest lease or unit boundary line 990 feet.

County Kiowa

Lease Name COSSELL Well# 1-27

Domestic well within 330 feet: yes no

Municipal well within one mile: yes no

Depth to Bottom of fresh water 100-160 mhc feet

Lowest usable water formation Kiowa

Depth to Bottom of usable water 200 feet

Surface pipe by Alternate: 1 XX 2

Surface pipe to be set 400 feet

Conductor pipe if any required 0 feet

Ground surface elevation 2285 feet MSL

This Authorization Expires 12-27-85

Approved By RCH/KCC 12-27-84

I certify that we will comply with K.S.A. 55-101, et seq., plus eventually plugging hole to K.C.C. specifications.

Date 12/26/84 Signature of Operator or Agent

Vince J. Grass

Title Division Area Engineer

mhc IUDHE 12/27/84 Form C-1 4/84

Must be filed with the K.C.C. five (5) days prior to commencing well
This card void if drilling not started within six (6) months of date received by K.C.C.


CONSERVATION DIVISION
Wichita, Kansas

DEC 27 1984

12-27-84

Important procedures to follow:

1. Notify District office before setting surface casing.
2. Set surface casing by circulating cement to the top.
3. File completion forms ACO-1 with K.C.C. within 90 days of well completion, following instructions on ACO-1, side 1, and including copies of wireline logs.
4. Notify District office 48 hours prior to old well workover or re-entry.
5. Prior to plugging, prepare a plugging plan, then obtain agreement from the appropriate district office for an approved plugging plan.
6. Submit plugging report (CP-4) to K.C.C. after plugging is completed.
7. Obtain an approved injection docket number before disposing of salt water.
8. Notify K.C.C. within 10 days when injection commences or terminates.
9. If an alternate 2 completion, cement in the production pipe from below any usable water to surface within 120 days of spud date.

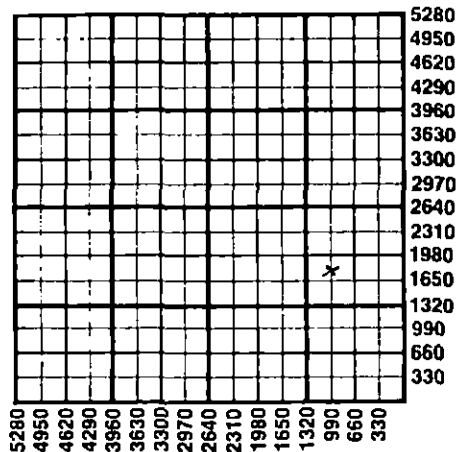

RECEIVED
STATE CORPORATION COMMISSION
A Regular Section of Land
Not a Regular Section of Land

State Corporation Commission of Kansas
Conservation Division
200 Colorado Derby Building
Wichita, Kansas 67202
(316) 263-3238