

STATE OF KANSAS
STATE CORPORATION COMMISSION.


WELL PLUGGING RECORD

FORMATION PLUGGING RECORD

Give All Information Completely
Make Required Affidavit
Mail or Deliver Report to:
Conservation Division
State Corporation Commission
800 Bismarck Building
Wichita, Kansas

Strike out upper line
when reporting plug-
ging of formations.

NORTH

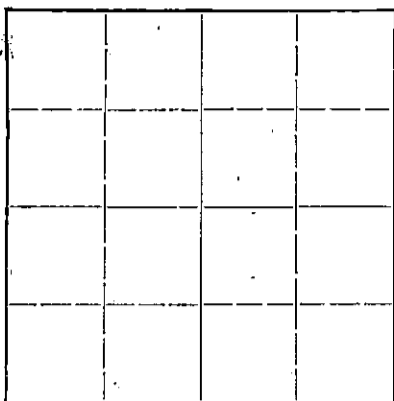

Locate well correctly on above
Section Plat

Barton County SW/4 Sec 30 Twp 20 Rge 13 (E) W (W)
Location as "NE 1/4 NW 1/4 SW 1/4" or footage from lines 200' fr SL and 200' fr EL
Lease Owner Phillips Petroleum Company
Lease Name Titus Well No 1
Office Address Box 779 Great Bend, Kansas
Character of Well (completed as Oil, Gas or Dry Hole) Completed as oil well
Date well completed August 17, 1948
Application for plugging filed May 23, 1949
Application for plugging approved May 23, 1949
Plugging commenced May 23, 1949
Plugging completed May 26, 1949
Reason for abandonment of well or producing formation Unprofitable to operate.
If a producing well is abandoned, date of last production May 18, 1949
Was permission obtained from the Conservation Division or its agents before plugging was com-
menced? Yes

Name of Conservation Agent who supervised plugging of this well C. D. Stough
Producing formation Lansing-Kansas City Depth to top 3199 Bottom 3411 Total Depth of Well 3437 Feet
Show depth and thickness of all water, oil and gas formations. PBSD 3370'

OIL, GAS OR WATER RECORDS

CASING RECORD

Formation	Content	From	To	Size	Put In	Pulled Out
Heebner	Dry	3074		8 5/8"	851'	
Toronto	Dry	3094				
Brown Lime	Dry	3189				
L.K.C.	Oil	3199	3411	5 1/2"	3445'	2498'

Describe in detail the manner in which the well was plugged, indicating where the mud fluid was placed and the method or methods used in introducing it into the hold. If cement or other plugs were used, state the character of same and depth placed, from _____ feet to _____ feet for each plug set.

Filled hole with sand from 3370' to 3175'. Ran 5 sacks of cement.
Mudded hole to 250'. Ran 15 sacks cement. Mudded hole to 30'.
Ran 10 sacks cement to cap. Pipe was shot at 2700-2650-2600-2550-2500'.

(If additional description is necessary, use BACK of this sheet)

Correspondence regarding this well should be addressed to Phillips Petroleum Company
Address Box 779 Great Bend, Kansas

STATE OF Kansas, COUNTY OF Barton, ss.
A. L. Rhodes (employee of owner) or ~~Notary Public~~ of the above-described well,
being first duly sworn on oath, says: That I have knowledge of the facts, statements, and matters herein contained and the log of the above-
described well as filed and that the same are true and correct. So help me God.


(Signature) *A. L. Rhodes*

Box 779 Great Bend, Kansas
(Address)

SUBSCRIBED AND SWORN to before me this 6th day of June, 1949

My commission expires March 27, 1950

Notary Public.

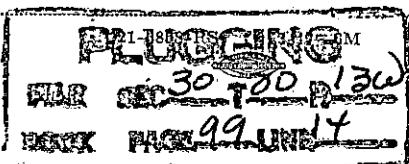

15.009.05897.0000

Form No. 873

Formation Record

Lease Titus

Well No. 1

FROM	TO	Formation	REMARKS
0	104	Sand	Elevation 1897' DF
104	150	Surface sand	785
150	170	Hard sand and Iron	1112
170	343	Shale and shells	
343	365	Shale	
365	565	Red Bed and shale	
565	785	Shale shells	
785	805	Anhydrite	
805	860	Shale, shells and sand	
860	1030	Red Bed, shale and shells	
1030	1350	Shale and shells	
1350	1565	Shale	
1565	1630	Salt, shale and shells	
1630	1685	Lime, shells and shale	
1685	1865	Lime and shale	
1865	2000	Broken lime	
2000	2095	Lime	
2095	2205	Lime and shale	
2205	2300	Broken lime	
2300	3020	Lime and shale	
3020	3317	Lime	Top Heebner 3074'. Top Toronto 3094'.
3317	3423	Lime and shale	Top Brown Lime 3189'. Top L.K.C. 3199'.
3423	3427	Lime, shale and sand	Base L.K.C. 3411'.
3427	3437½	Granite	Top We. Pre-Cambrian 3425'.

RECEIVED
 Conservation Div.
 JUN 11 1949
 STATE CORPORATION
 COMMISSION
 KANSAS

PLUGGING
 FILE REC-30-T-20-R(3W)
 BOOK PAGE 99 LINE 14