

Give All Information Completely
Make Required Affidavit
Mail or Deliver Report to:
Conservation Division
State Corporation Commission
211 No. Broadway
Wichita, Kansas

WELL PLUGGING RECORD

Barton County, Sec. 13 Twp 20 Rge. 13 (E) (W) X

Location as "NE/CNW/SW" or footage from lines N 2 SE NW SW

Lease Owner Leo J. Dreiling Oil Company

Lease Name Selle Well No. 1

Office Address Victoria, Kansas

Character of Well (completed as Oil, Gas or Dry Hole) D. & A.

Date well completed 10/13/63 19

Application for plugging filed 10/13/63 19

Application for plugging approved 10/13/63 19


Plugging commenced 10/13/63 19

Plugging completed 10/13/63 19

Reason for abandonment of well or producing formation -0-

If a producing well is abandoned, date of last production -0- 19

Was permission obtained from the Conservation Division or its agents before plugging was commenced? Yes

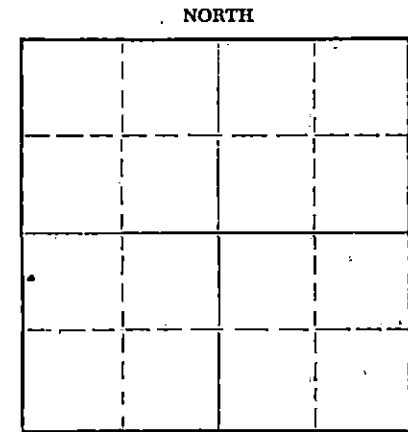

Locate well correctly on above Section Plat

Name of Conservation Agent who supervised plugging of this well Donald Truan

Producing formation -0- Depth to top -0- Bottom -0- Total Depth of Well 3470' Feet

Show depth and thickness of all water, oil and gas formations.

OIL, GAS OR WATER RECORDS

CASING RECORD

FORMATION	CONTENT	FROM	TO	SIZE	PUT IN	PULLED OUT
Surface Pipe				8 5/8"	203'	-0-

Describe in detail the manner in which the well was plugged, indicating where the mud fluid was placed and the method or methods used in introducing it into the hole. If cement or other plugs were used, state the character of same and depth placed, from _____ feet to _____ feet for each plug set.

Filled hole with rotary drilled cement, Sun Cementing Co. pumped plug down with 80 sacks cement, filling hole to surface.

RECEIVED
STATE CORPORATION COMMISSION

OCT 30 1963

CONSERVATION DIVISION
Wichita, Kansas

(If additional description is necessary, use BACK of this sheet)

Name of Plugging Contractor L. J. Dreiling & Sons, Inc.

Address Victoria, Kansas

STATE OF Kansas, COUNTY OF Ellis, ss.
L. Leo F. Dreiling a partner (Employee of owner, or owner or operator)

well, being first duly sworn on oath, says: That I have knowledge of the facts, statements, and matters herein contained and the log of the above-described well as filed and that the same are true and correct. So help me God.

(Signature) Leo F. Dreiling

(Address)

SUBSCRIBED AND SWORN to before me this 29th day of October, 1963

Robert Zimmerman
Notary Public.

My commission expires August 11, 1965

15.009 01569.0000

L. J. DREILING and SONS, Inc.
VICTORIA, KANSAS

WELL LOG

Company Leo J. Drilling Oil Company
Victoria, Kansas

Sec. 13 Twp. 20 Rng. 13

Farm Selle No. 1

Location W2
SE NW SW

Total Depth 3470'

County Barton County, Kansas

Comm. 10/7/63 Comp. 10/13/63

Elevation: D.F. 1855' est

Contractor L. J. DREILING & SONS, INC.
VICTORIA, KANSAS

G. R.

Casing Record

Cement Record

Production:

203' - - - - 8 5/8"

275 sacks cement

D. & A.

Figures Indicate Bottom of Formations

0 - 50a Gray
50 - 107
107 - 126
126 - 203
203 - 669
669 - 697
697 - 960
960 - 1650
1650 - 1825
1825 - 1975
1975 - 2300
2300 - 2895
2895 - 2965
2965 - 3050
3050 - 3193
3193 - 3255
3255 - 3276
3276 - 3355
3355 - 3430
3430 - 3470
3470

Surface Clay
Hard Sand
Sand
Shale
Shale & Shells
Anhydrite
Shale
Shale & Lime
Shale & Lime
Lime & Shale
Shale
Shale
Lime
Lime
Shale & Lime
Lime
Lime
Lime
Lime
Lime
TD

STATE OF KANSAS)
COUNTY OF ELLIS)

ss.

I, Leo F. Dreiling, of the L. J. Dreiling and Sons, Inc.,
upon oath states that the above and foregoing is a true and correct
copy from the Daily Drilling Report from your Selle No. 1.

Leo F. Dreiling
LEO F. DREILING

Subscribed and sworn to before me this 29th day of October, 1963.

James Zimmerman
NOTARY PUBLIC

My Commission Expires: August 14, 1965