


WELL PLUGGING RECORD

Give All Information Completely
Make Required Affidavit
Mail or Deliver Report to:
Conservation Division
State Corporation Commission
212 North Market, Insurance Bldg.
Wichita, Kansas

NORTH

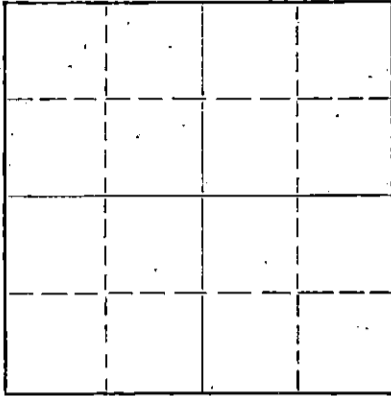

Locate well correctly on above
Section Plat

Barton County, Sec. 7 Twp. 20S Rge. 13W (E) (W)
Location as "NE/CNW/SW" or footage from lines C SW NE NE
Lease Owner E. K. Edmiston
Lease Name RUSSELL-BREWER Well No. 1
Office Address 501 First National Bank Bldg., Wichita, Ks.
Character of Well (completed as Oil, Gas or Dry Hole) dry hole
Date well completed 2/6/65 19__
Application for plugging filed 2/6/65 19__
Application for plugging approved 2/6/65 19__
Plugging commenced 2/6/65 19__
Plugging completed 2/6/65 19__
Reason for abandonment of well or producing formation dry hole

If a producing well is abandoned, date of last production --- 19__
Was permission obtained from the Conservation Division or its agents before plugging was commenced? yes

Name of Conservation Agent who supervised plugging of this well Donald Truan
Producing formation --- Depth to top --- Bottom --- Total Depth of Well 3570 Feet
Show depth and thickness of all water, oil and gas formations.

OIL, GAS OR WATER RECORDS

CASING RECORD

| FORMATION | CONTENT | FROM | TO | SIZE | PUT IN | PULLED OUT |
|-----------|---------|------|----|--------|--------|------------|
| | | | | 8-5/8" | 771' | |
| | | | | | | |
| | | | | | | |
| | | | | | | |
| | | | | | | |
| | | | | | | |
| | | | | | | |
| | | | | | | |

Describe in detail the manner in which the well was plugged, indicating where the mud fluid was placed and the method or methods used in introducing it into the hole. If cement or other plugs were used, state the character of same and depth placed, from --- feet to --- feet for each plug set.

plug hole 6:30 - 8:00 p.m., plug hole as follows: heavy mud to 420 feet, plug 1/4 hulls 25 sacks cement through drill pipe, heavy mud 180 feet 1/4 sack hulls 25 sacks cement through drill pipe, heavy mud to 40 feet, 1/2 sack hulls solid bridge 10 sacks cement, job completed 8:00 p.m.

RECEIVED
STATE CORPORATION COMMISSION
1965

2-9-1965 FEB 9 1965

CONSERVATION DIVISION
Wichita, Kansas

(If additional description is necessary, use BACK of this sheet)

Name of Plugging Contractor E. K. Edmiston Drilling Co., Inc.
Address 501 First National Bank Bldg., Wichita, Kansas


STATE OF KANSAS, COUNTY OF SEDGWICK, ss.
E. K. Edmiston, owner (employee of owner) (operator) of the above-described well, being first duly sworn on oath, says: That I have knowledge of the facts, statements, and matters herein contained and the log of the above-described well as filed and that the same are true and correct. So help me God.

(Signature) E. K. Edmiston
501 First National Bank Bldg, Wichita,
(Address) Kansas

SUBSCRIBED AND SWORN TO before me this 8th day of February, 1965

My commission expires August 25, 1968

A. B. Barger
Notary Public.

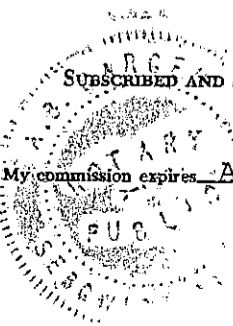

DRILLER'S LOG

Company: E. K. Edmiston
 501 First National Bank Bldg.
 Wichita, Kansas 67202

Rotary Drilling Commenced: January 27, 1965

Rotary Drilling Completed: February 6, 1965

Well Name: RUSSELL-BREWER No. 2
 C SW NE NE 7-20S-13W
 Barton County, Kansas

Contractor: E. K. Edmiston Drilling Co., Inc.
 501 First National Bank Bldg.
 Wichita, Kansas 67202

Casing Record: 8-5/8" at 771' with 400 sacks cement

LOG

Measurements from top of Rotary Bushing

| | |
|-------------------|----------|
| Sand | 0 - 200 |
| Sand and Shale | 325 |
| Shale and Red Bed | 768 |
| Anhydrite | 796 |
| Shale | 1580 |
| Lime | 1790 |
| Lime and Shale | 1989 |
| Shale and Lime | 2905 |
| Lime | 3003 |
| Lime and Shale | 3191 |
| Lime | 3549 |
| Lime and Shale | 3560 |
| Lime | 3570 RTD |

RECEIVED
STATE CORPORATION COMMISSION

FEB 9 1965

CONSERVATION DIVISION
Wichita, Kansas

The undersigned, E. K. Edmiston, President of E. K. Edmiston Drilling Co., Inc., hereby certifies on behalf of said company that the above log is a true and correct log of the formations encountered in drilling the above well, as reflected by the daily drilling reports.

E. K. EDMISTON DRILLING CO., INC.

By E. K. Edmiston
E. K. Edmiston, President

STATE OF KANSAS,
SS:
SEDGWICK COUNTY,

BE IT REMEMBERED that on this 8th day of February, 1965, before me, the undersigned, a Notary Public within and for said county and state, came E. K. Edmiston, known to me to be the same person who executed the foregoing instrument as President and on behalf of E. K. Edmiston Drilling Co., Inc., and he duly acknowledged the execution of the same for himself and for said company.

IN WITNESS WHEREOF, I have hereunto set my hand and official seal on the day and year last above written.

C. B. Bargaen
A. B. Bargaen, Notary Public

My commission expires
August 25, 1968

