


WELL PLUGGING RECORD

Give All Information Completely  
Make Required Affidavit  
Mail or Deliver Report to:  
Conservation Division  
State Corporation Commission  
800 Bitting Building  
Wichita, Kansas

NORTH

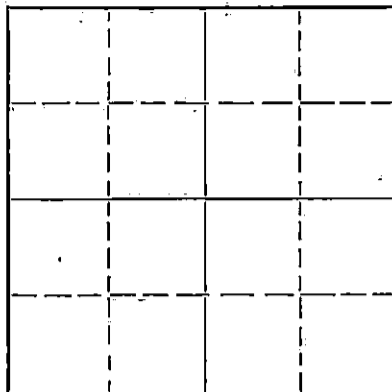

Locate well correctly on above  
Section Flat

Barton County, Sec. 19 Twp. 20S Rge. 11W (E) (W)  
Location as "NE/CNW $\frac{1}{4}$ SW $\frac{1}{4}$ " or footage from lines NW NW NW  
Lease Owner Tri-State Petroleum, Inc.,  
Lease Name Opal E. Clark Well No. 1  
Office Address c/o J. D. Conway, Tribune Bldg., Hastings, Nebr.  
Character of Well (completed as Oil, Gas or Dry Hole) Abandoned oil well  
Date well completed June 14, 1948 19  
Application for plugging filed June 15, 1951 19  
Application for plugging approved June 18, 1951 19  
Plugging commenced June 22, 1951 19  
Plugging completed July 1, 1951 19  
Reason for abandonment of well or producing formation oil depleted

If a producing well is abandoned, date of last production 19  
Was permission obtained from the Conservation Division or its agents before plugging was commenced? Yes

Name of Conservation Agent who supervised plugging of this well M. A. Rives  
Producing formation Depth to top Bottom Total Depth of Well 3658 Feet  
Show depth and thickness of all water, oil and gas formations.

OIL, GAS OR WATER RECORDS

CASING RECORD

Formation	Content	From	To	Size	Put In	Pulled Out
				8-5/8"	880'	
				5-1/2"	3658'	

Describe in detail the manner in which the well was plugged, indicating where the mud fluid was placed and the method or methods used in introducing it into the hole. If cement or other plugs were used, state the character of same and depth placed, from feet to feet for each plug set.

880 feet of 8-5/8 inch circulated with cement.  
Lane Wells plug set at 3622 feet. Top perforation  
3593 feet. Filled back with gravel to 3585 feet.  
Run 5 sacks of cement with dump bailer. Mud to  
250 feet. Set bridge and run 25 sacks of cement.  
Mud to 35 feet. Set rock bridge. Run 10 sacks of  
cement. Steel plate welded on 8-5/8 inch at 3'.  
Recovery of 5 1/2" casing was 2032 Feet.

(If additional description is necessary, use BACK of this sheet)

Name of Plugging Contractor Carrol Brothers,  
Address Great Bend, Kansas

STATE OF Nebraska COUNTY OF Adams, ss.  
James D. Conway (employee of owner) or (owner or operator) of the above-described well,  
being first duly sworn on oath, says: That I have knowledge of the facts, statements, and matters herein contained and the log of the above-described well as filed and that the same are true and correct. So help me God.

(Signature) James D. Conway

(Address)

SUBSCRIBED AND SWORN to before me this 26 day of July 1951

My commission expires Dec. 4, 1956

23-8390-s 6-51-20M

Fred R. Prognos Notary Public.

JUL 28 1951 7-28-51

PLUGGING CONSERVATION DIVISION

FILE SEC 19 T 20 R 11W  
PAGE 88 LINE 38

Clark #1

NW/4 of section 19,  
Township 20S, Range 11W,  
Barton County, Kansas

Total Depth: 3658'  
Comm: 5-27-48 Comp: 6-11-48

Cellar	5
Sand and Shale	90
Blue Clay	160
Blue Shale & Gravel	240
Shale	295
Sand	385
Red Bed, Sand & Shale	455
Shale and Shells	580
Shale	620
Red Bed	735
Red Bed	870
Anhydrite	875
Anhydrite	910
Red Bed, Shale, Sand	1350
Red Bed and Shale	1480
Shale and Lime	1740
Shale and Lime	1835
Lime, broken	1945
Lime	2045
Lime & Shale	2150
Lime & Shale	2245
Lime & Shale	2360
Lime & Shale	2445
Shale and Shells	2550
Shale and Lime	2680
Lime and Shale	2900
Lime and Shale	2945
Lime and Shale	3030
Lime and Shale	3080
Lime	3110
Lime	3140
Lime	3195
Lime and Shale	3245
Lime	3300
Lime	3340
Lime, Kansas City	3363

**PLUGGING**

FILE SEC      T      R     

BOOK PAGE      LINE     

CONSERVATION DIVISION  
Hastings, Kansas

15.009.07163.0000

Lime	3400
Lime	3484
Lime	3510
Lime	3555
Conglomerate & Arbuckle	3586
Arbuckle	3591
Lime	3596
Lime	3606
Lime	3615
Lime	3622
Lime	3630
Lime	3647
Lime	3656
Lime	3658
Total Depth	3658

Witness Charles N. Guil  
 Date June 15/51

Certified to:  
 TRI-STATE PETROLEUM, INC.  
 By Howard Swanson

RECEIVED  
 JUN 15 1951  
 DIVISION  
 OF REVENUE