


STATE OF KANSAS
STATE CORPORATION COMMISSION

Form CP-1

Give All Information Completely
Make Required Affidavit
Mail or Deliver Report to
Conservation Division
State Corporation Commission

WELL PLUGGING RECORD

P. O. Box 17027
Wichita, Kansas 67217

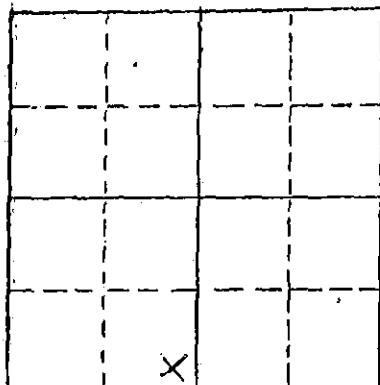

Locate well correctly on above
Section Plat

Barton County. Sec. 19 Twp. 20 Rge. 14 (E) W (W)
Location as "NE/CNW/SW" or footage from lines SE SE SW
Lease Owner Joe Brougher Oil Co.
Lease Name Smith Well No. #1
Office Address 5513 Apache ; Great Bend, Kansas 67530
Character of Well (completed as Oil, Gas or Dry Hole) _____
Date well completed _____ 19____
Application for plugging filed _____ December 1973
Application for plugging approved _____ December 1973
Plugging commenced _____ December 22 1973
Plugging completed _____ March 7 1974
Reason for abandonment of well or producing formation _____

If a producing well is abandoned, date of last production _____ 19____
Was permission obtained from the Conservation Division or its agents before plugging was commenced? Yes

Name of Conservation Agent who supervised plugging of this well Don Truan
Producing formation _____ Depth to top _____ Bottom _____ Total Depth of Well _____ Feet
Show depth and thickness of all water, oil and gas formations.

OIL, GAS OR WATER RECORDS				CASING RECORD		
FORMATION	CONTENT	FROM	TO	SIZE	PUT IN	PULLED OUT
				8 5/8"	861	None
				4 1/2"	3624	2820

Describe in detail the manner in which the well was plugged, indicating where the mud fluid was placed and the method or methods used in introducing it into the hole. If cement or other plugs were used, state the character of same and depth placed, from _____ feet to _____ feet for each plug set.

December 22, 1973 Plugged off bottom. Dumped sand to 3200'.
Mixed and dumped 4 sx of cement.

March 7, 1974 Plugged off top. Set 25' rock bridge from
350' to 375'. Filled 8 5/8" surface casing
from 350' to base of cellar.

4-3-74
RECEIVED
STATE CORPORATION COMMISSION
APR 3 - 1974
CONSERVATION DIVISION
Wichita, Kansas


Name of Plugging Contractor RUSS CASING PULLING, INC.
Address P. O. Box 1082 ; Great Bend, Kansas 67530

STATE OF Kansas COUNTY OF Barton ss.
Joe Brougher d/b/a Joe Brougher Oil Company (employee of owner) or (owner or operator) of the above-described well, being first duly sworn on oath, says: That I have knowledge of the facts, statements, and matters herein contained and the log of the above-described well as filed and that the same are true and correct. So help me God.

(Signature) Joe Brougher
5513 Apache, Great Bend, Kansas 67530
(Address)

Subscribed and sworn to before me this 2nd day of April, 1974

September 26, 1976 Vlami Brougher Notary Public.

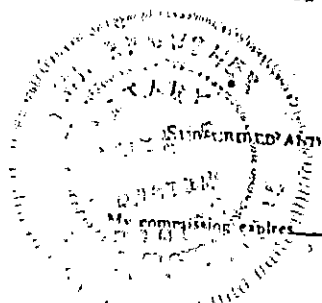

Joe Brougher Oil Co.
 Smith 641 - Unruh E. Field
 SE.. SE.. SW 19-205-14W
 Barton Co. Kans.
 Elev. 1907 K.B.

K.B. Log Tops.

TOPUNA	3650	- 1043
HEBNER	3159	- 1282
TORONTO	3208	- 1301
Douglas	3222	- 1315
Lansing	3300	- 1398
ARBORLE	3574	- 1669
T.D.	3624	

Spud 1.. 31.. 69 8 7/8 @ 861' - 450 sv.
 4 1/2 @ 3624' - 75 sv.

RECEIVED
 STATE CORPORATION COMMISSION

NOV 29 1973

CONSERVATION DIVISION
 Wichita, Kansas