

STATE OF KANSAS  
STATE CORPORATION COMMISSION


Form CP-4

Give All Information Completely  
Make Required Affidavit  
Mail or Deliver Report to:  
Conservation Division  
State Corporation Commission  
212 No. Market  
Wichita, Kansas

WELL PLUGGING RECORD

Barton County, Sec. 19 Twp. 20 Rge. (E) 11(W)

Location as "NE/CNWSW" or footage from lines SW SW SE  
Lease Owner Home-Stake Production Company  
Lease Name V & J Habiger Well No. 1  
Office Address 1015 Philtower, Tulsa, Oklahoma  
Character of Well (completed as Oil, Gas or Dry Hole) oil  
Date well completed \_\_\_\_\_ 19\_\_\_\_  
Application for plugging filed May 29 19 69  
Application for plugging approved \_\_\_\_\_ 19\_\_\_\_  
Plugging commenced June 2 19 69  
Plugging completed June 5 19 69  
Reason for abandonment of well or producing formation depleted

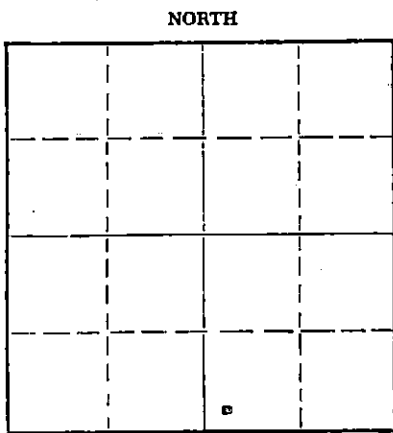

Locate well correctly on above  
Section Plat

If a producing well is abandoned, date of last production \_\_\_\_\_ 19\_\_\_\_  
Was permission obtained from the Conservation Division or its agents before plugging was commenced? yes

Name of Conservation Agent who supervised plugging of this well Donald Truan  
Producing formation \_\_\_\_\_ Depth to top \_\_\_\_\_ Bottom \_\_\_\_\_ Total Depth of Well 3665 Feet  
Show depth and thickness of all water, oil and gas formations.

OIL, GAS OR WATER RECORDS

CASING RECORD

FORMATION	CONTENT	FROM	TO	SIZE	PUT IN	PULLED OUT
		0	862'	8 5/8"	862'	none
		0	3602'	5 1/2"	3602'	2580.00

Describe in detail the manner in which the well was plugged, indicating where the mud fluid was placed and the method or methods used in introducing it into the hole. If cement or other plugs were used, state the character of same and depth placed, from \_\_\_\_\_ feet to \_\_\_\_\_ feet for each plug set.

Plugged back bottom from 3665' to 3360' and dumped 5 sacks of cement.

Set 15' rock bridge from 350' to 335'. Dumped 5 yards of ready mix cement to base of cellar.

RECEIVED  
STATE CORPORATION COMMISSION  
JUN 13 1969  
CONSERVATION DIVISION  
Wichita, Kansas

(If additional description is necessary, use BACK of this sheet)  
Name of Plugging Contractor Pipe Pullers, Inc.  
Address Box 486, Ellinwood, Kansas

STATE OF Kansas COUNTY OF Barton, ss.  
Evelyn Roth (employee of owner) or (owner or operator) of the above-described well, being first duly sworn on oath, says: That I have knowledge of the facts, statements, and matters herein contained and the log of the above-described well as filed and that the same are true and correct. So help me God.

(Signature) Evelyn Roth  
Ellinwood, Kansas  
(Address)

SUBSCRIBED AND SWORN TO before me this 10th day of June 19 69

My commission expires Feb. 10, 1971  
George A. Meyer Notary Public.

15.009.20238.0000

**KANSAS GEOLOGICAL SOCIETY**  
**KANSAS WELL LOG BUREAU - KANSAS WELL SAMPLE BUREAU**  
 KANSAS GEOLOGICAL SOCIETY BUILDING  
 508 EAST MURDOCK - WICHITA, KANSAS

COPY

COMPANY HOME STATKE PRODUCTION

SEC. 19 T. 20 R. 14W  
 LOC. SW SW SE

FARM V & J. Habiger NO. 1

COUNTY Barton

TOTAL DEPTH 3665'


COMM. 7-24-68

COMP. 7-31-68

SHOT OR TREATED

CONTRACTOR Aspen Drlg.

ISSUED 11-2-68

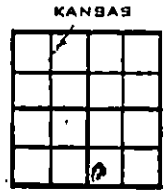

**CASING**

20	10	
15	8	5/8" 872' cem w/ 200 sx
12	6	
13	5	1/2" 3602' cem w/ 150 sx

ELEVATION 1906' KB

PRODUCTION PMP 58 BOPD, NW/  
 Lans 3420-23

FIGURES INDICATE BOTTOM OF FORMATIONS

Sand	160
Shale	305
Dakota Sand	380
Red Bed	600
Shale	851
Anhydrite	893
Shale	1880
Lime-Shale	2313
Shale-Lime	3070
Lime-Shale	3207
Heebner	3211
Lime-Shale	3410
Lime	3425
Lime-Shale	3540
Lime, Shale, Chert & Sand	3596
Arbuckle	3665

Ran 36 jts. (872') 8 5/8" casing set at 862'; cemented with 200 sx Pozmix & 200 sx Sunset. Cement circulated.

DST #1	3371-3425
DST #2	3434-3540
DST #3	3590-3596
DST #4	3634-3644

Ran 113 jts. (3602') 5 1/2" casing set at 3602', cemented with 150 sacks.

AFFIDAVIT

State of Kansas )  
 ) ss:  
 County of Barton )

**RECEIVED**  
 STATE CORPORATION COMMISSION  
 JUN 2 1968  
 CONSERVATION DIVISION  
 Wichita, Kansas

The undersigned, being duly sworn on oath, states that the above statement and log are a true and correct record and log of the well

TOPS: LOG

Topeka	2939
Heebner	3183
Toronto	3197
Douglas	3215
Brown lime	3284
Lansing	3292
Base Kansas City	3507
Arbuckle	3566
LTD	3665