


Give All Information Completely  
Make Required Affidavit  
Mail or Deliver Report to:  
Conservation Division  
State Corporation Commission  
800 Building  
Wichita, Kansas

WELL PLUGGING RECORD

NORTH

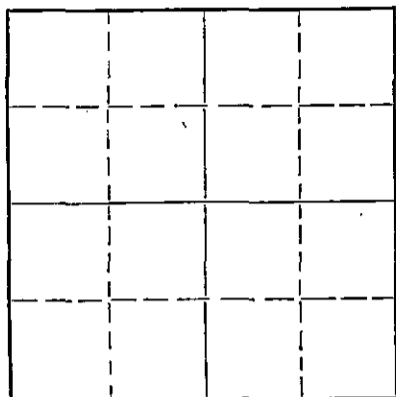

Locate well correctly on above  
Section Plat

BARTON County. Sec. 1 Twp. 20 Rge. 13 (E) W (W)  
Location as "NE/CNW/SW" or footage from lines NW NW SE  
Lease Owner SHELLEY-MILLER DRILLING, INC.  
Lease Name Rogers Well No. 1  
Office Address 205 Miller Building, Wichita, Kansas  
Character of Well (completed as Oil, Gas or Dry Hole) Dry Hole  
Date well completed April 10 19 54  
Application for plugging filed April 10 19 54  
Application for plugging approved April 10 19 54  
Plugging commenced April 11 19 54  
Plugging completed April 11 19 54  
Reason for abandonment of well or producing formation No Commercial Shows

If a producing well is abandoned, date of last production \_\_\_\_\_ 19\_\_\_\_  
Was permission obtained from the Conservation Division or its agents before plugging was commenced? Yes

Name of Conservation Agent who supervised plugging of this well Warren H. Horner  
Producing formation \_\_\_\_\_ Depth to top \_\_\_\_\_ Bottom \_\_\_\_\_ Total Depth of Well 3475 Feet  
Show depth and thickness of all water, oil and gas formations.

OIL, GAS OR WATER RECORDS

CASING RECORD

FORMATION	CONTENT	FROM	TO	SIZE	PUT IN	PULLED OUT
				8 5/8"	135'	

Describe in detail the manner in which the well was plugged, indicating where the mud fluid was placed and the method or methods used in introducing it into the hole. If cement or other plugs were used, state the character of same and depth placed, from \_\_\_\_\_ feet to \_\_\_\_\_ feet for each plug set.

Plugged with 100 sacks of cement through swedge in 8 5/8" surface casing.

(If additional description is necessary, use BACK of this sheet)

Name of Plugging Contractor \_\_\_\_\_  
Address \_\_\_\_\_

STATE OF KANSAS, COUNTY OF SEDGWICK, ss.  
Richard A. Shelley (employee of owner) or (owner or operator) of the above-described well, being first duly sworn on oath, says: That I have knowledge of the facts, statements, and matters herein contained and the log of the above-described well as filed and that the same are true and correct. So help me God.

(Signature) Richard A. Shelley  
President  
205 Miller Building, Wichita, Kansas  
(Address)

SUBSCRIBED AND SWORN TO before me this 14 day of April, 19 54

My commission expires March 24, 1956 Leona M. Baker Notary Public.



4-17-54

PLUGGING  
FILED SEC 1 T20 R13W  
COOK PAGE 26 LINE 31

COMPANY:

Shelley-Miller Drilling, Inc.  
205 Miller Building  
Wichita, Kansas

Rotary Drilling Commenced: 4-1-54  
Rotary Drilling Completed: 4-10-54

LOCATION:

Rogers No. 1  
NW NW/SE 1-20-13W  
Barton County, Kansas

CONTRACTOR:

Shelley-Miller Drilling, Inc.  
205 Miller Building  
Wichita, Kansas

CASING RECORD:

8 5/8" 24# Sims Casing Set @ 135'

L O G

(Measurements from top of Rotary Bushing to bottom of formation)

Sand	92	
Sand & Shale	124	
Iron Sand	135	
Shale	155	
Iron Sand	175	
Shale	230	
Iron Sand	270	
Red Bed	649	
Anhydrite	687	
Shale & Shells	1330	
Shale & Lime	1865	
Lime	2010	
Lime & Shale	2935	
Lime	3475	Rotary T.D.

The undersigned, Richard A. Shelley, President of Shelley-Miller Drilling, Inc., hereby certifies in behalf of said company, that the above log is a true and correct log of the formation encountered in drilling the above well as reflected by the Daily Drilling Reports.

SHELLEY-MILLER DRILLING, INC.

By Richard A. Shelley  
President

STATE OF KANSAS )  
COUNTY OF SEDGWICK ) SS

BE IT REMEMBERED, that on this 14th day of April, 1954, before me, the undersigned, a Notary Public, duly commissioned in and for the county and state aforesaid, came Richard A. Shelley, President, and known to me to be the same person who executed the foregoing instrument of writing in behalf of Shelley-Miller Drilling, Inc., as President of said company, and he duly acknowledged the execution of the same for himself and for said company.

IN WITNESS WHEREOF, I have hereunto set my hand and official seal on the day and year last above written.

Leona M. Baker  
Notary Public

My Commission Expires:  
March 24, 1956

PLUGGING  
FILE SEC 1 T20.13W  
BOOK PAGE 26 LINE 31