

STATE OF KANSAS  
STATE CORPORATION COMMISSION

Form CP-4


WELL PLUGGING RECORD

Give All Information Completely  
Make Required Affidavit  
Mail or Deliver Report to:  
Conservation Division  
State Corporation Commission  
211 No. Broadway  
Wichita, Kansas

Barton County, Sec. 1 Twp. 20 Rge. 13 (E) W (W)

Location as "NE/CNWSW" or footage from lines NW SE SW  
Lease Owner Bea Drilling Co., Inc.  
Lease Name Rogers Well No. 1  
Office Address Box 247, Ellinwood, Kansas  
Character of Well (completed as Oil, Gas or Dry Hole) Dry-hole workover.  
Date well completed Org. 11/30/61 --- 12/10/62 Workover 19  
Application for plugging filed Verb. 12/27 Written 12/28/62 19  
Application for plugging approved 12/28/62 19  
Plugging commenced 12/28/62 19  
Plugging completed 12/29/62 19  
Reason for abandonment of well or producing formation Not enough oil to pay to produce.

NORTH

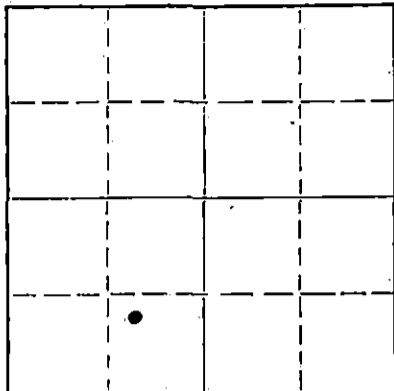

Locate well correctly on above Section Plat

If a producing well is abandoned, date of last production \_\_\_\_\_ 19\_\_\_\_  
Was permission obtained from the Conservation Division or its agents before plugging was commenced? Yes

Name of Conservation Agent who supervised plugging of this well Don Truan, Russell, Kansas  
Producing formation Lansing-K. C. Depth to top 3185 Bottom 3408 Total Depth of Well 3474 Feet  
Show depth and thickness of all water, oil and gas formations.

OIL, GAS OR WATER RECORDS

CASING RECORD

FORMATION	CONTENT	FROM	TO	SIZE	PUT IN	PULLED OUT
		0	238	8 5/8"	238	None
		0	13290	4 1/2"	3290	2823

Describe in detail the manner in which the well was plugged, indicating where the mud fluid was placed and the method or methods used in introducing it into the hole. If cement or other plugs were used, state the character of same and depth placed, from \_\_\_\_\_ feet to \_\_\_\_\_ feet for each plug set.

Filled w/sand from 3246 to 3240  
Run 4 sacks cement, to 3220,  
Shot casing @2815, pulled same.  
Welded collar on surface casing,  
Pumped in 10 sacks of mud and 80 sacks of cement.

STATE CORPORATION COMMISSION

JAN 11 1963

1-11-63

CONSERVATION DIVISION  
WICHITA, KANSAS

(If additional description is necessary, use BACK of this sheet)

Name of Plugging Contractor Glenn & Smith Pipe Pulling Co. (Permit # 396)  
Address Box 114, Ellinwood, Kansas

STATE OF Kansas, COUNTY OF Barton, ss.

C. F. Krebbiel (employee of owner) or (owner or operator) of the above-described well, being first duly sworn on oath, says: That I have knowledge of the facts, statements, and matters herein contained and the log of the above-described well as filed and that the same are true and correct. So help me God.

(Signature)

C. F. Krebbiel

Box 247, Ellinwood, Kansas  
(Address)

SUBSCRIBED AND SWORN to before me this 9 day of January, 19 63

My commission expires

January 11, 1965

Marilyn Spacil

Notary Public.



BEA DRILLING CO., INC.  
Box 247  
Ellinwood, Kansas

DRILLING LOG

James W. Hershberger, et al  
Rogers #1, NW SE SW 1-20-13W  
Barton County, Kansas

Staked: 11/16/61                      Elevation: 1836' KB  
Started: 11/17/61  
Set Surface: 11/22/61  
Completed: 11/30/61

Casing Record: Set 238' of  
8 5/8" casing, cemented w/  
225 sacks. 2 c.c. 1 aguagel  
Cement circulated.

Formation Tops:	
Heebner	3058
Toronto	3078
Douglas	3091
Brown lime.	3172
Lansing	3185
Base: K. C.	3408
Conglomerate	3414
Rotary Total Depth	3474

Drillers Log

(All measurements to bottom of formations.)

Surface clay, sand, shale	238
Sand	260
Red bed	320
Red bed	660
Anhydrite	695
Shale & shells	1235
Salt & shale	1525
Lime & shale	1700
Shale & lime	1975
Lime & shale	2310
Shale	2520
Shale & shells	2705
Lime & shale	2885
Lime	3k05 3305-
Shale & lime	3230
Lime	3474
Total Depth	3474

JAN 11 1963

I hereby certify that the above log is true and correct as reflected by the daily drilling reports.

C. F. Krehbiel  
C. F. Krehbiel

STATE OF KANSAS    )  
                          ) SS  
COUNTY OF BARTON )

Subscribed and sworn to before me this 14 day of December, 1962.

Marilyn Spacil  
Notary Public

My commission expires January 11, 1965