

STATE OF KANSAS  
STATE CORPORATION COMMISSION

WELL PLUGGING RECORD


OR

FORMATION PLUGGING RECORD

Strike out upper line  
when reporting plug-  
ging of formations.

Give All Information Completely  
Make Required Affidavit  
Mail or Deliver Report to:  
Conservation Division  
State Corporation Commission  
800 Bittling Building  
Wichita, Kansas

NORTH

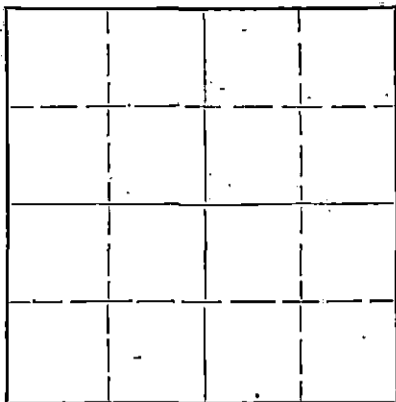

Locate well correctly on above  
Section Plat

Barton County. Sec. 36 Twp. 20 Rge. (E) 13(W)  
Location as "NE 1/4 NW 1/4 SW 1/4" or footage from lines. SW NW SW  
Lease Owner. Westgate-Greenland Oil Company, et al  
Lease Name. Schartz Well No. 2  
Office Address. 1022 Union National Bank Building, Wichita 2, Kansas  
Character of Well (completed as Oil, Gas or Dry Hole) dry hole  
Date well completed September 25, 1948 19.  
Application for plugging filed October 25, 1948 19.  
Application for plugging approved October 26, 1948 19.  
Plugging commenced November 17, 1948 19.  
Plugging completed December 9, 1948 19.  
Reason for abandonment of well or producing formation dry hole

If a producing well is abandoned, date of last production 19.  
Was permission obtained from the Conservation Division or its agents before plugging was com-  
menced? yes

Name of Conservation Agent who supervised plugging of this well yes C. D. Stough  
Producing formation Depth to top Bottom Total Depth of Well Feet  
Show depth and thickness of all water, oil and gas formations.

OIL, GAS OR WATER RECORDS

CASING RECORD

Formation	Content	From	To	Size	Put In	Pulled Out
Surface		0	296	8 5/8"	296'	none
Lansing		0	3241	5 1/2"	3241'	1885

Describe in detail the manner in which the well was plugged, indicating where the mud fluid was placed and the method or methods used in introducing it into the hole. If cement or other plugs were used, state the character of same and depth placed, from feet to feet for each plug set.

T.D. 3331 feet, plugged back with rock to 3240 feet  
Run 5 sacks cement from 3240 to 3210 feet  
Filled with heavy mud to 295 feet and run 15 sacks cement.  
Filled with heavy mud to 15 feet and run 5 sacks cement, to cellar base

1-4-49  
RECEIVED  
JAN X 4 1949  
STATE CORPORATION  
KANSAS

(If additional description is necessary, use BACK of this sheet)

Correspondence regarding this well should be addressed to G. E. Bitler, c/o Westgate-Greenland Oil Company.  
Address 1022 Union National Bank Building, Wichita 2, Kansas

STATE OF Kansas, COUNTY OF Sedgwick, ss.  
G. E. Bitler (employee of owner) or (owner or operator) of the above-described well,

being first duly sworn on oath, says: That I have knowledge of the facts, statements, and matters herein contained and the log of the above-described well as filed and that the same are true and correct. So help me God.

(Signature) G. E. Bitler

1022 Union National Bank Building, Wichita 2, Ks  
(Address)

SUBSCRIBED AND SWORN to before me this 31st day of December, 19 48

Esther T. Swell  
Notary Public.

My commission expires May 25, 1949

22-2625 2-48-15M

PLUGGING  
FILE REC 36 T 20 R 13 W  
BOOK PAGE 69 LINE 45

COMPANY: Westgate-Greenland Oil Company  
 CONTRACTOR: Mallard Drilling Company  
 FARM: Schartz #2  
 LOCATION: SW-NW SW Sec. 36-20-13W, Barton County, Kansas  
 COMMENCED: August 27, 1948- Rotary  
 September 13, 1948- Cardwell  
 COMPLETED: September 5, 1948- Rotary  
 September 25, 1948- Cardwell

0	to	225	Surface sand
225	to	285	Shale
285	to	294	Surface sand
294	to	675	Red bed
675	to	950	Shale and shells
950	to	1400	Shale and shells
1400	to	1585	Shale and lime
1585	to	1680	Lime
1680	to	1925	Lime
1925	to	2080	Lime and shells
2080	to	2885	Shale and lime
2885	to	3130	Lime
3130	to	3224	Lime
3224	to	3240	Lime-brown
3240	to	3241	Lime-T. D. Rotary
3241	to	3247	Lime
3247	to	3259	Lime
3259	to	3266	Lime-show oil
3266	to	3276	Lime-Hard
3276	to	3280	Lime-soft show oil
3280	to	3288	Lime, soft, oil pay
3288	to	3299 $\frac{1}{2}$	Lime-hard
3299 $\frac{1}{2}$	to	3308	Shale
3308	to	3315	Broken lime
3315	to	3331	Lime
		3331	T. D.

Set 296 feet of 8 5/8" surface pipe. Cemented with 200 sacks cement.  
 Set 3241 feet of 5 1/2" casing. Cemented with 50 sacks cement.

Tops: 3238-Kansas City

DRY AND ABANDONED

**PLUGGING**  
 FILE SEC 36 T 20 R 13W  
 BOOK PAGE 64 LINE 15

COMPANY: Westgate-Greenland Oil Company  
 CONTRACTOR: Mallard Drilling Company  
 FARM: Schartz #2  
 LOCATION: SW NW SW Section 36-20-13  
 Barton County, Kansas  
 COMMENCED: August 27, 1948--Rotary  
 September 13, 1948--Cardwell  
 COMPLETED: September 5, 1948--Rotary  
 September 25, 1948--Cardwell

0	to	225	Surface sand
225	to	285	Shale
285	to	294	Surfacesand
294	to	675	Red bed
675	to	950	Shale and shells
950	to	1400	Shale and shells
1400	to	1585	Shale and lime
1585	to	1680	Lime
1680	to	1925	Lime
1925	to	2080	Lime and shells
2080	to	2885	Shale and lime
2885	to	3130	Lime
3130	to	3224	Lime
3224	to	3240	Lime--brown
3240	to	3241	Lime--T.D. Rotary
3241	to	3247	Lime
3247	to	3259	Lime
3259	to	3266	Lime--show oil
3266	to	3276	Lime--hard
3276	to	3280	Lime--soft show oil
3280	to	3288	Lime, soft, oil pay
3288	to	3299 <sup>1</sup> / <sub>2</sub>	Lime--hard
3299 <sup>1</sup> / <sub>2</sub>	to	3308	Shale
3308	to	3315	Broken lime
3315	to	3331	Lime
		3331	T.D.

Set 296 feet of 3 5/8" surface pipe. Cemented with 200 sacks cement.  
 Set 5 1/2" pipe at 3241. Cemented with 50 sacks cement.

TOPS;--3238--Kansas City

DRY AND ABANDONED

C E R T I F I C A T E

I, C. C. Nelson, do hereby certify that the above and foregoing is a true and correct copy of log of the Schartz #2, Section 36-20-13, Barton County, Kansas, as reflected by files of the Mallard Drilling Company.

*C. C. Nelson*

Subscribed and sworn to before me a Notary Public, within and for Sedgwick County, Kansas, this 29th day of September 1948.

*Harwell Wright*

My commission expires 12/4/48

PLUGGING  
 FILE SEC. 36 T. 20 R. 13 W  
 BOOK PAGE 64 LINE 45