


WELL PLUGGING RECORD

Give All Information Completely
Make Required Affidavit
Mail or Deliver Report to:
Conservation Division
State Corporation Commission
800 Bittling Building
Wichita, Kansas

NORTH

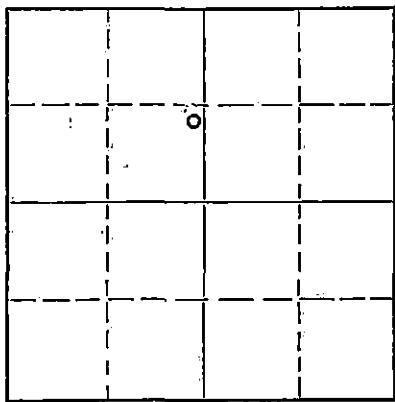

Locate well correctly on above
Section Plat

Pawnee County. Sec. 2 Twp 20S Rge. (E) 16 (W)
Location as "NE/CNW%SW%" or footage from lines C NW SE NW
Lease Owner Gulf Oil Corporation
Lease Name M. Nelson Well No. 3
Office Address Box 661, Tulsa, Oklahoma
Character of Well (completed as Oil, Gas or Dry Hole) Oil
Date well completed 6-30 19 45
Application for plugging filed 7-19 19 54
Application for plugging approved 7-21 19 54
Plugging commenced 8-3- 19 54
Plugging completed 8-11 19 54
Reason for abandonment of well or producing formation Reached economic limit.

If a producing well is abandoned, date of last production 4-13 19 54
Was permission obtained from the Conservation Division or its agents before plugging was commenced? Yes

Name of Conservation Agent who supervised plugging of this well M. A. Rives
Producing formation Arbuckle Depth to top 3665' Bottom 3736' Total Depth of Well 3736' Feet
Show depth and thickness of all water, oil and gas formations.

OIL, GAS OR WATER RECORDS

CASING RECORD

FORMATION	CONTENT	FROM	TO	SIZE	PUT IN	PULLED OUT
				5-1/2"	3725'	2963'
				8-5/8"	1015'	None

Describe in detail the manner in which the well was plugged, indicating where the mud fluid was placed and the method or methods used in introducing it into the hole. If cement or other plugs were used, state the character of same and depth placed, from _____ feet to _____ feet for each plug set.

Plugged back with sand from 3736' to 3650'. Ran 5 sx. cement at 3650'. Mudded hole to 300' placed rock bridge at 300' with 20 sx. cement on top of bridge. Filled with mud to 35' capped with 10 sx. cement.

(If additional description is necessary, use BACK of this sheet)

Name of Plugging Contractor C. E. Shull
Address Great Bend, Kansas

STATE OF Kansas COUNTY OF Rice, ss.
W. H. Duley (employee of owner) or (owner or operator) of the above-described well, being first duly sworn on oath, says: That I have knowledge of the facts, statements, and matters herein contained and the log of the above-described well as filed and that the same are true and correct. So help me God.

(Signature) W. H. Duley
Box 544, Chase, Kansas
(Address)

SUBSCRIBED AND SWORN TO before me this 17th day of August, 19 54

My commission expires April 14, 1956

24-7868-5 3-53-20M

PLUGGING
FILE SEC 2 T 20 R 16W
BOOK PAGE 49 LINE 41

RECEIVED
STATE CORPORATION COMMISSION
AUG 19 1954 8-19-54
CONSERVATION DIVISION
Wichita, Kansas

WELL NO. 3 LEASE Natilia Delacy COMPANY Gulf Oil Corporation A.F.E. 2380
 DATE—DRILLING BEGAN 5-29-45 WELL COMPLETED 6-30-45 FIRST PRODUCTION 6-19-45
 SAND RECORD Artificial line 3555' - 3735' TOTAL DEPTH 3736'
 INITIAL PRODUCTION OIL: 3000 Barrels (2 1/2" Gauge ret. 7/10) Corrected gravity 40.7
 WATER: None

CASING RECORD

SIZE	WEIGHT	THD.	CLASS	MAKE	SET AT DEPTH	SACKS CEMENT	LBS. CAL. CHLO.	PULLED	LEFT IN
8 5/8"	22.7	BS	REG	AMCO 54	1015'	120	-	-	1015'
6 1/2"	14	BS	REG	Bull. Co. Grade II.	3725'	100	-	-	3725'

S 2 T 20S R 16W

Farmed County, Kansas

ELEVATION 273' above 5 1/2" collar.

ACCOMMOD: 6-30-45 with 500 gallons.

FORMATION RECORD:

- From 30:
- 0' 10' Cellar
 - 100 Surface soil and sand
 - 370 Sand and shale
 - 420 Shale and shells
 - 550 Sand and shells
 - 590 Shale and shells
 - 605 Sand and shells
 - 670 Sand and shale
 - 735 Shale and shells
 - 1005 Red bed and sand
 - 1012 Red bed
 - 1050 anhydrite
 - 1445 Shale and shells
 - 1200 Shale and lime, broken
 - 1775 Lime and shale
 - 2035 Shale and lime
 - 2210 Lime and shale
 - 2270 Lime
 - 2435 Lime, broken
 - 2470 Lime
 - 2510 Lime, broken
 - 2730 Lime, broken and shale
 - 2735 Lime and shale
 - 2850 Shale and lime
 - 2950 Lime and shale
 - 3025 Lime
 - 3110 Lime and shale
 - 3170 Lime
 - 3225 Lime and shale
 - 3335 Shale and lime
 - 3390 Lime
 - 3375 Lime and shale
 - 3736 Lime TOTAL DEPTH

RECEIVED
STATE CORPORATION COMMISSION
JUL 21 1954
CONSERVATION DIVISION
Wichita, Kansas

PLUGGING
FLK SEC 2 T 20 R 16W
BOOK PAGE 49 LINE 41