

WELL PLUGGING RECORD

Give All Information Completely
Make Required Affidavit
Mail or Deliver Report to:
Conservation Division
State Corporation Commission
800 Bittling Building
Wichita, Kansas

Pawnee County, Sec. 2 Twp. 20S Rge. (E) 16(W)

Location as "NE/CNW/SW" or footage from lines C NW SW NW

Lease Owner Gulf Oil Corporation

Lease Name M. Nelson Well No. 4

Office Address Box 661 Tulsa, Oklahoma

Character of Well (completed as Oil, Gas or Dry Hole) Oil and Gas

Date well completed 7-23 19 45

Application for plugging filed 3-26 19 54

Application for plugging approved 3-26 19 54


Plugging commenced 3-27- 19 54

Plugging completed 4-6 19 54

Reason for abandonment of well or producing formation Fuel gas production for lease insufficient for lease requirements.

If a producing well is abandoned, date of last production 1-27 19 54

Was permission obtained from the Conservation Division or its agents before plugging was commenced? Yes

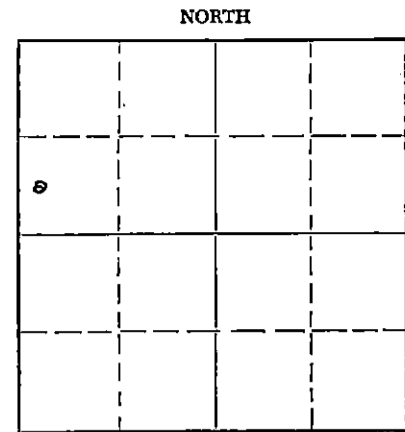

Locate well correctly on above Section Plat

Name of Conservation Agent who supervised plugging of this well R. A. Rives

Producing formation Arbuckle Depth to top 3663 Bottom 3701 Total Depth of Well PB 3701 Feet

Show depth and thickness of all water, oil and gas formations.

OIL, GAS OR WATER RECORDS

CASING RECORD

FORMATION	CONTENT	FROM	TO	SIZE	PUT IN	PULLED OUT
				8-5/8"	1017'	None
				5-1/2"	3719'	2896'

Describe in detail the manner in which the well was plugged, indicating where the mud fluid was placed and the method or methods used in introducing it into the hole. If cement or other plugs were used, state the character of same and depth placed, from _____ feet to _____ feet for each plug set.

Mudded hole to 320', set rock bridge 320-300', dumped 20 sacks cement at 300'. Mudded hole to 35' of surface capped with 10 sacks cement. Well plugged and abandoned.

(If additional description is necessary, use BACK of this sheet)

Name of Plugging Contractor Morgan Well Plugging Service

Address Hutchinson, Kansas

STATE OF Kansas, COUNTY OF Rice, ss.

W. H. Duley (employee of owner) or (~~owner~~) of the above-described well, being first duly sworn on oath, says: That I have knowledge of the facts, statements, and matters herein contained and the log of the above-described well as filed and that the same are true and correct. So help me God.

(Signature) W. H. Duley

Box 544 Chase, Kansas (Address)

SUBSCRIBED AND SWORN TO before me this 9th day of April, 1954

My commission expires April 14, 1956

S. M. Council Notary Public.

24-7368-6 3-53-20M
PLUGGING
FILE SEC 2 T 20 R 16W
BOOK PAGE 25 LINE 34

RECEIVED
STATE CORPORATION COMMISSION
APR 14 1954
4-10-54
CONSERVATION DIVISION



15.145.01218.0000

PETROLEUM AND ITS PRODUCTS

GULF OIL CORPORATION

GULF BUILDING

P. O. BOX 661 · TULSA 2, OKLAHOMA

GYPSY PRODUCTION
DIVISION

P. O. Box 544
Chase, Kansas
March 26, 1954

Mr. M. A. Rives
Box 148
Pratt, Kansas

Dear Sir:

Gulf Oil Corporation is preparing to plug and abandon its M. Nelson Well No. 4, AOW, located in C NW SW NW of Section 2-20S-16W, Pawnee County, Kansas. Application to plug is being handled from our Tulsa Office.

Well record is as follows:

TD 3729', PB to 3701'.
Top Arbuckle 3663'.
8-5/8"OD surface pipe cemented at 1017'
with 100 sacks. Cement circulated.
5-1/2"OD casing cemented at 3719' with
100 sacks. Pipe perforated 3704' - 3708',
and 3680' - 3685'.

Morgan Well Plugging Service, Hutchinson, Kansas, has been awarded plugging contract, and expects to move to the location early next week. Mr. Morgan will contact you for plugging instructions before work is started.

We would appreciate your noting your plugging procedure on one copy of this letter and returning to this address for our use.

GULF OIL CORPORATION

W. H. Duley
W. H. Duley
Area Superintendent

Attn Mr. Rives

LFB:ab
*red this letter from chase office but have never
rid the Permit to Plug from your office*
Rives