

STATE OF KANSAS  
STATE CORPORATION COMMISSION

WELL PLUGGING RECORD

OR

FORMATION PLUGGING RECORD

Strike out upper line when reporting plugging of formations.

Give All Information Completely  
Make Required Affidavit  
Mail or Deliver Report to:  
Conservation Division  
State Corporation Commission  
309 Biting Building  
Wichita, Kansas

Rice County, Sec. 21 Twp. 20 Rge. 9 (W) est

Location as "NE $\frac{1}{4}$ NW $\frac{1}{4}$ SW $\frac{1}{4}$ " or footage from lines Cen. E. Line SE $\frac{1}{2}$  NW $\frac{1}{2}$

Lease Owner... The Derby Oil Company

Lease Name... McGlynn Well No. 1

Office Address... Wichita, Kansas

Character of Well (completed as Oil, Gas or Dry Hole) Dry Hole

Date well completed... November 16 19 41

Application for plugging filed... November 17 19 41

Application for plugging approved... November 18 19 41


Plugging commenced... November 19 19 41

Plugging completed... November 29 19 41

Reason for abandonment of well or producing formation  
Dry Hole

If a producing well is abandoned, date of last production... 19

Was permission obtained from the Conservation Division or its agents before plugging was commenced? Yes

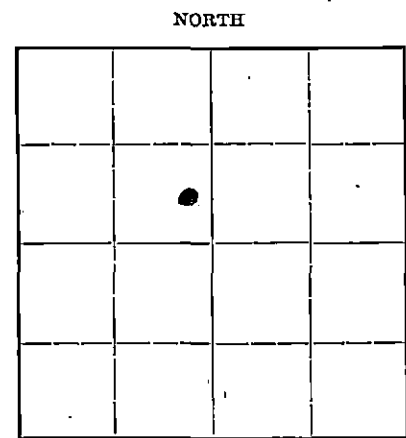

Locate well correctly on above Section Flat

Name of Conservation Agent who supervised plugging of this well... Ruel Durkee

Producing formation... Arbuckle Depth to top... 3285' Bottom... 3298' Total Depth of Well... 3298 Feet

Show depth and thickness of all water, oil and gas formations.

OIL, GAS OR WATER RECORDS


CASING RECORD

Formation	Content	From	To	Size	Put In	Pulled Out
				8 $\frac{1}{2}$ "	205'	None
				5 $\frac{1}{2}$ "	3286'	2900

Describe in detail the manner in which the well was plugged, indicating where the mud fluid was placed and the method or methods used in introducing it into the hole. If cement or other plugs were used, state the character of same and depth placed, from... feet to... feet for each plug set.

- 3298' to 3280' Rock
- 3280' to 3256' 4 Sacks Cement
- 3256' to 200' Mud
- 200' to 173' 10 Sacks Cement
- 173' to 10' Mud
- 10' to 3' 6 Sacks Cement
- 3' to Surface Earth

12-20-41

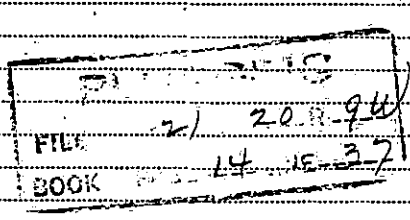

(If additional description is necessary, use BACK of this sheet)

Correspondence regarding this well should be addressed to... The Derby Oil Company  
Address... Wichita, Kansas

STATE OF... Kansas... COUNTY OF... Sedgwick... ss.  
S. E. Banks (employee of owner) or (owner or operator) of the above-described well,

being first duly sworn on oath, says: That I have knowledge of the facts, statements, and matters herein contained and the log of the above-described well as filed and that the same are true and correct. So help me God.

(Signature) S. E. Banks *S E Banks*

THE DERBY OIL COMPANY, Wichita, Kansas  
(Address)

Subscribed and Sworn to before me this... 19<sup>th</sup> day of... December... 19 41

My commission expires... 7-31-43

*[Signature]*  
Notary Public.

